

# T.4S. R.3W. Section 3, W.M.

Lot 5

Cluff  
DLC 61

NE Corner  
DLC 61

4.1

TL 4 3 03 3400

Well 1  
(YAMH 2807)  
and meter

Lot 6  
Lot 7

Well 1 (YAMH 2807) is located 1,135 feet south and 205 feet west from the NE corner, DLC 61

 Area (15.1 Acres) irrigated under Application G-18516, Permit G-17958.

 Commercial use

 Tax lot boundary

 Donation Land Claim boundary

 Water main line


11.0

Hwy 99 W

Riverwood Road

4 3  
9 10

Scale: 1" = 400'

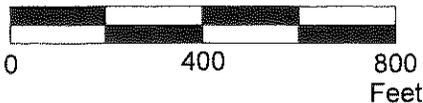

This map was prepared for the purpose of identifying the location of a water right only and is not intended to provide legal dimensions or location of property ownership lines.

Claim of Beneficial Use Map  
Application G-18516, Permit G-17958

Durant Vineyards c/o Ken Durant  
T.4S. R.3W. Section 3, W.M.

Pacific Hydro-Geology Inc.

07/2024

DurantG-18516COBUMap.cdr

