



This map is not intended to provide legal dimensions or locations of property ownership lines.

Section 6 T 18S R 5W Willamette Meridian

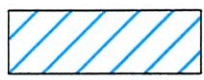

Authorized Place of Use App
G-18875 Permit G 18544

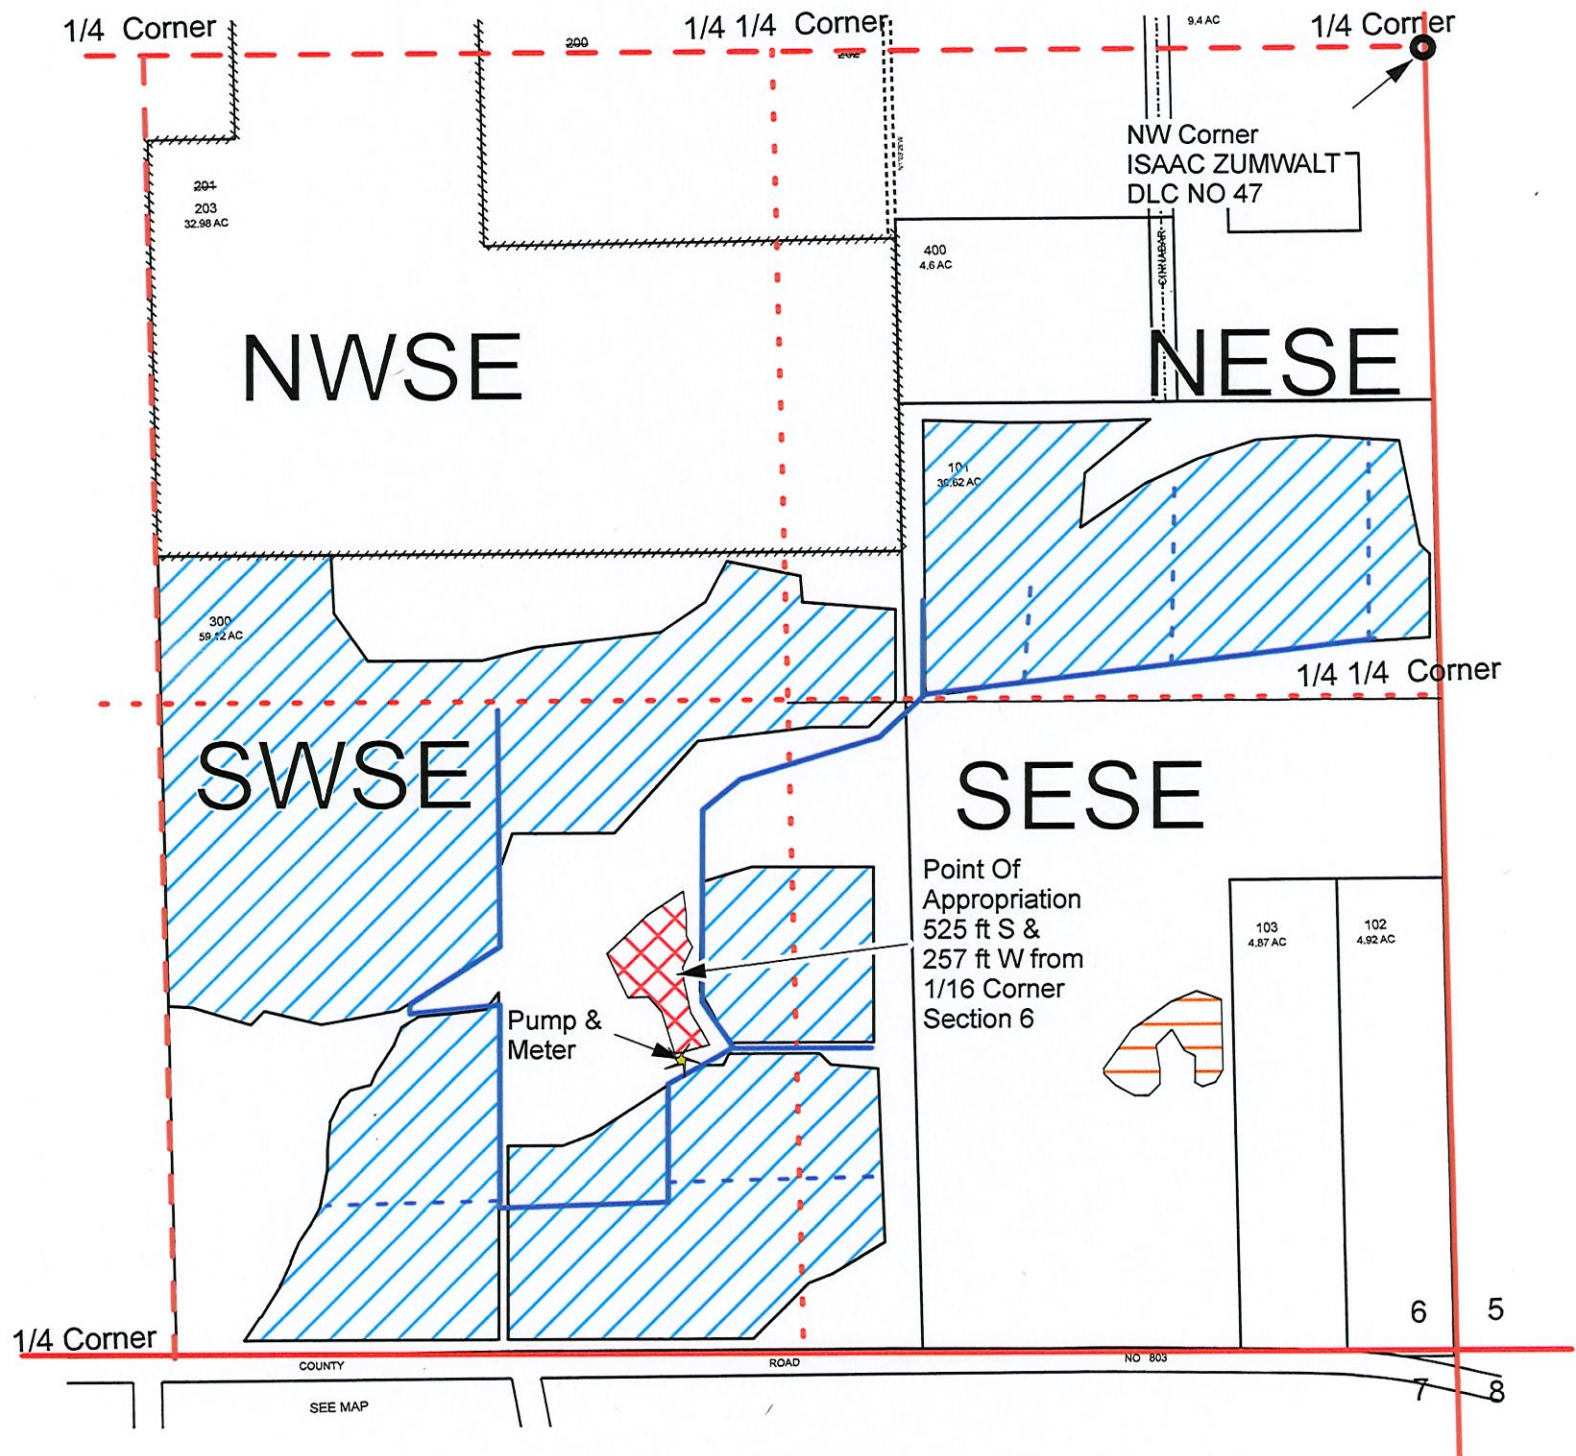


Pump & Meter



1 inch = 400 ft



Point of Appropriation

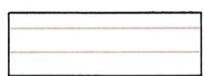

Water Right Cert 93088



Section Line



1/4 Section Line



1/4 1/4 Section Line



DLC Corner




Buried 2.5-Inch Main Line



Buried 2-Inch Lateral

Authorized Place of Use:					
Twp	Rng	Mer	Sec	Q-Q	Acres
18S	5W	WM	6	NESE	10.92
18S	5W	WM	6	NWSE	8.1
18S	5W	WM	6	SWSE	23.91
18S	5W	WM	6	SESE	2.96
				Total	45.89

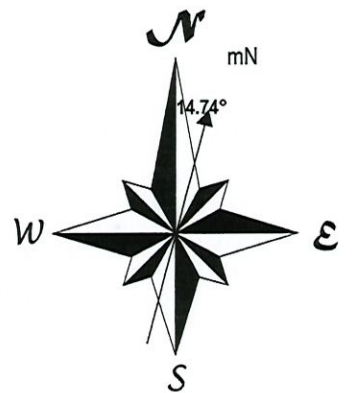

Received
SEP 04 2024



ISSUANCE DATE: 12/31/24

Derived from Lane County Tax
Map
18-05-06-40

Claim of Beneficial Use Map Application G- 18875 Permit G- 18544