



TOWNSHIP 4 SOUTH, RANGE 1 WEST, W.M.

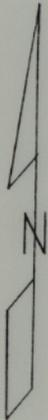

Scale 1" = 1320'


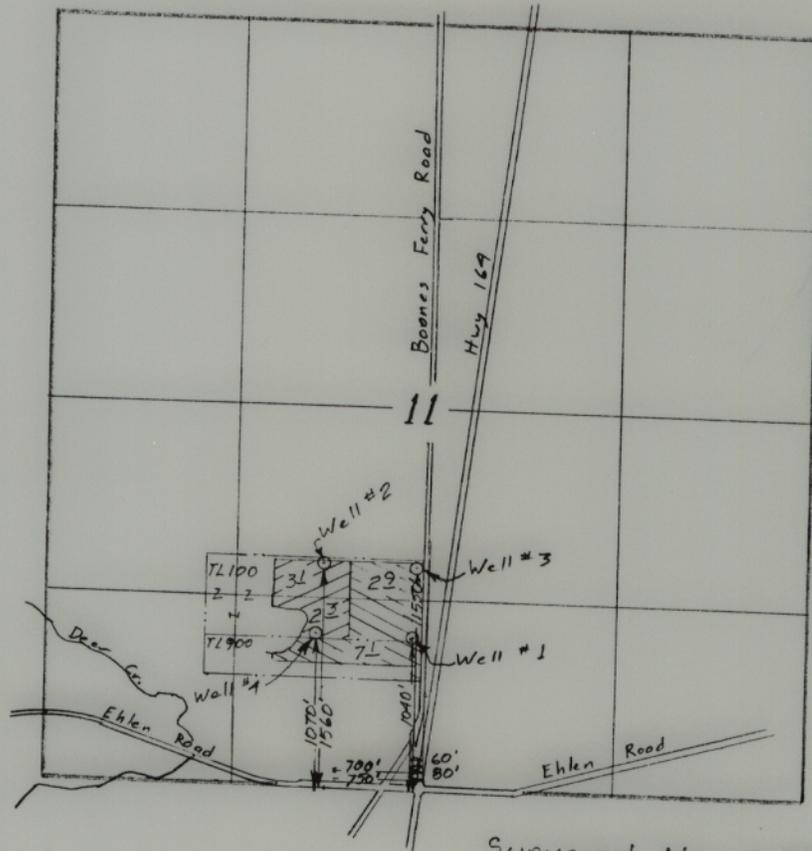


Surveyed Nov. 7, 2001

Claim of Beneficial Use Map  
for  
JEFF R. ALZNER

-  Irrigation
-  Nursery & Irrigation

Application G-14305  
Permit G-13257

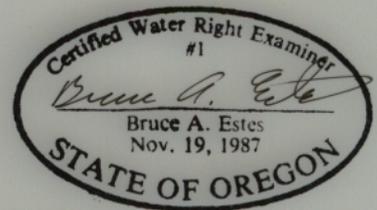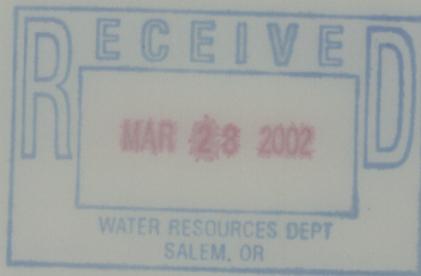

This map is for the purpose of locating a water right only and has no intent to provide legal dimensions or the location of property lines.

**ESTES SURVEYS, LLC**  
 6293 Sunnyview Rd. NE    60382 Arnold Rd.  
 Salem, OR 97305        Bend, OR 97702  
 (503) 585-7593            (503) 382-7391