


CLAIM OF BENEFICIAL USE MAP
 FOR APPLICATION G14031, PERMIT G12506, TRANSFER T-8352
 T2S, R25E & R26E W.M., MORROW COUNTY

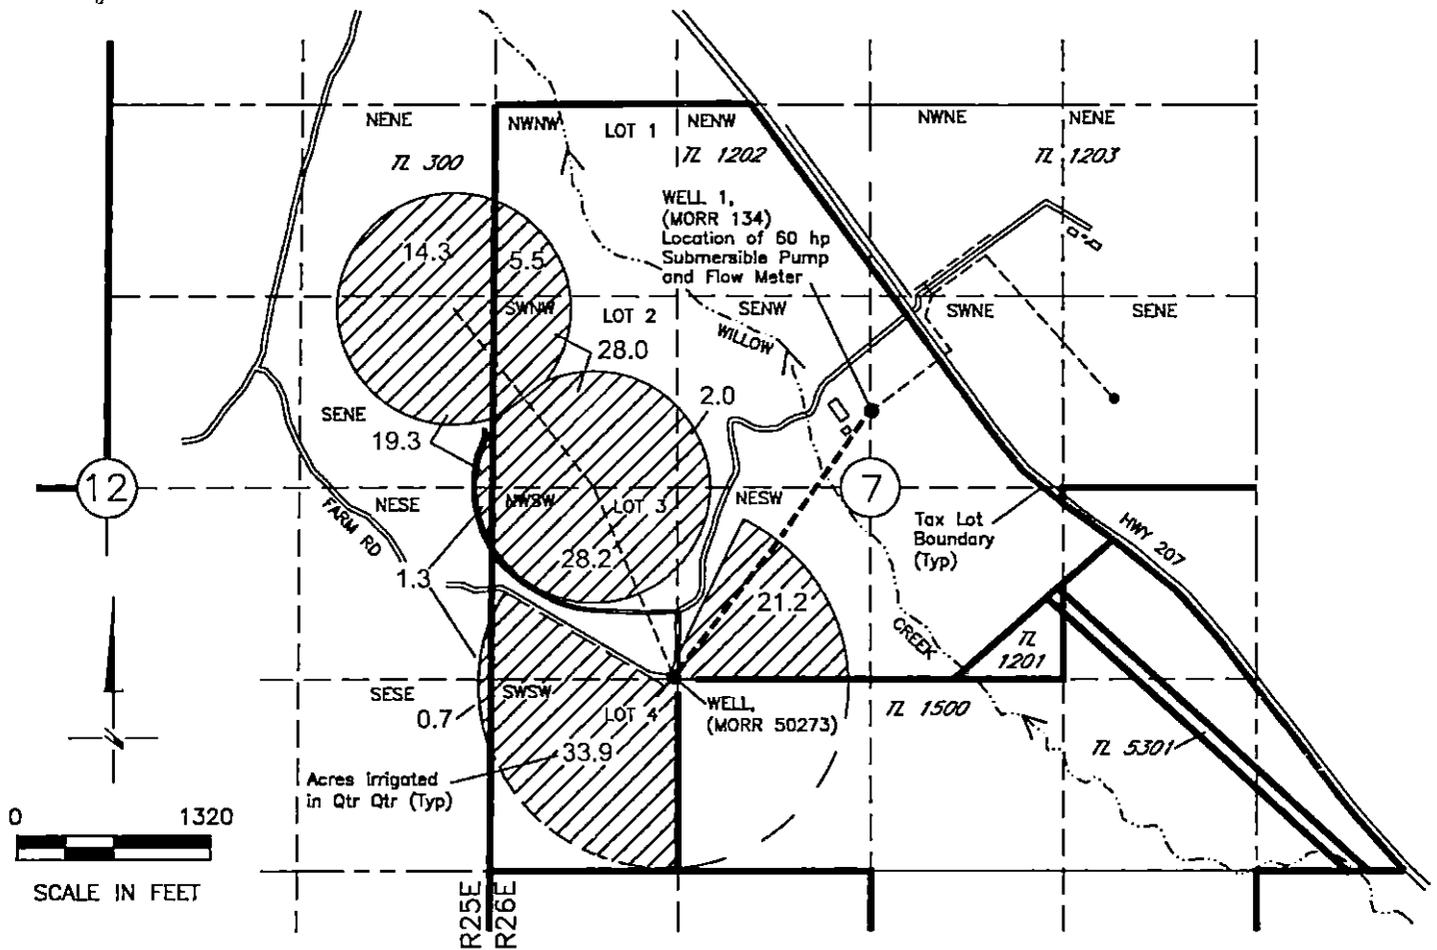

LEGEND

- 154.4 ac  PLACE OF USE
- BURIED PIPELINE (TYP)
- TAX LOT BOUNDARY (TYP)

POINT OF APPROPRIATION

- WELL 1 (MORR 134)
 LOCATED 2110' SOUTH
 AND 2630' WEST FROM
 THE NE CORNER OF
 SECTION 7



Reviews 6/30/29

NOTE:
 THE PURPOSE OF THIS MAP IS TO IDENTIFY THE APPROXIMATE LOCATION
 OF THE WATER RIGHT. IT IS NOT INTENDED TO PROVIDE INFORMATION
 RELATIVE TO THE LOCATION OF PROPERTY OWNERSHIP BOUNDARY LINES.

DGV Consulting, PLLC
 PHONE (509) 627-8717
 dalevconsulting@gmail.com
 Date: Mar 10, 2025