


T20S R36E WM HARNEY COUNTY, OR

PAGE 1 OF 2

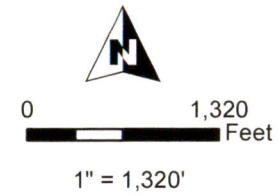

● Jack Well 1 & Meter

--- Creek

- - - Ditch

POU (IS)

Township

Section

----- Quarter Quarter

Tax Lot

Well Location:

Jack Well 1 (HARN 52974/L-125160):
1010' S, 880' E of N 1/4 Cor Sec 8

Received
DEC 05 2024
OWRD



RENEWS: 06/30/2026




CLAIM OF BENEFICIAL USE MAP OTIS CREEK RANCH, LLC

Date: 10/31/2024 Ap G-18753 Permit G-18219

This map is not intended
to provide legal dimensions
or locations of property
ownership lines.

WATER RIGHT SERVICES, LLC
PO BOX 1830, BEND, OR 97709
WWW.OREGONWATER.US CCB # 197121
johnshort@usa.com 541-389-2837

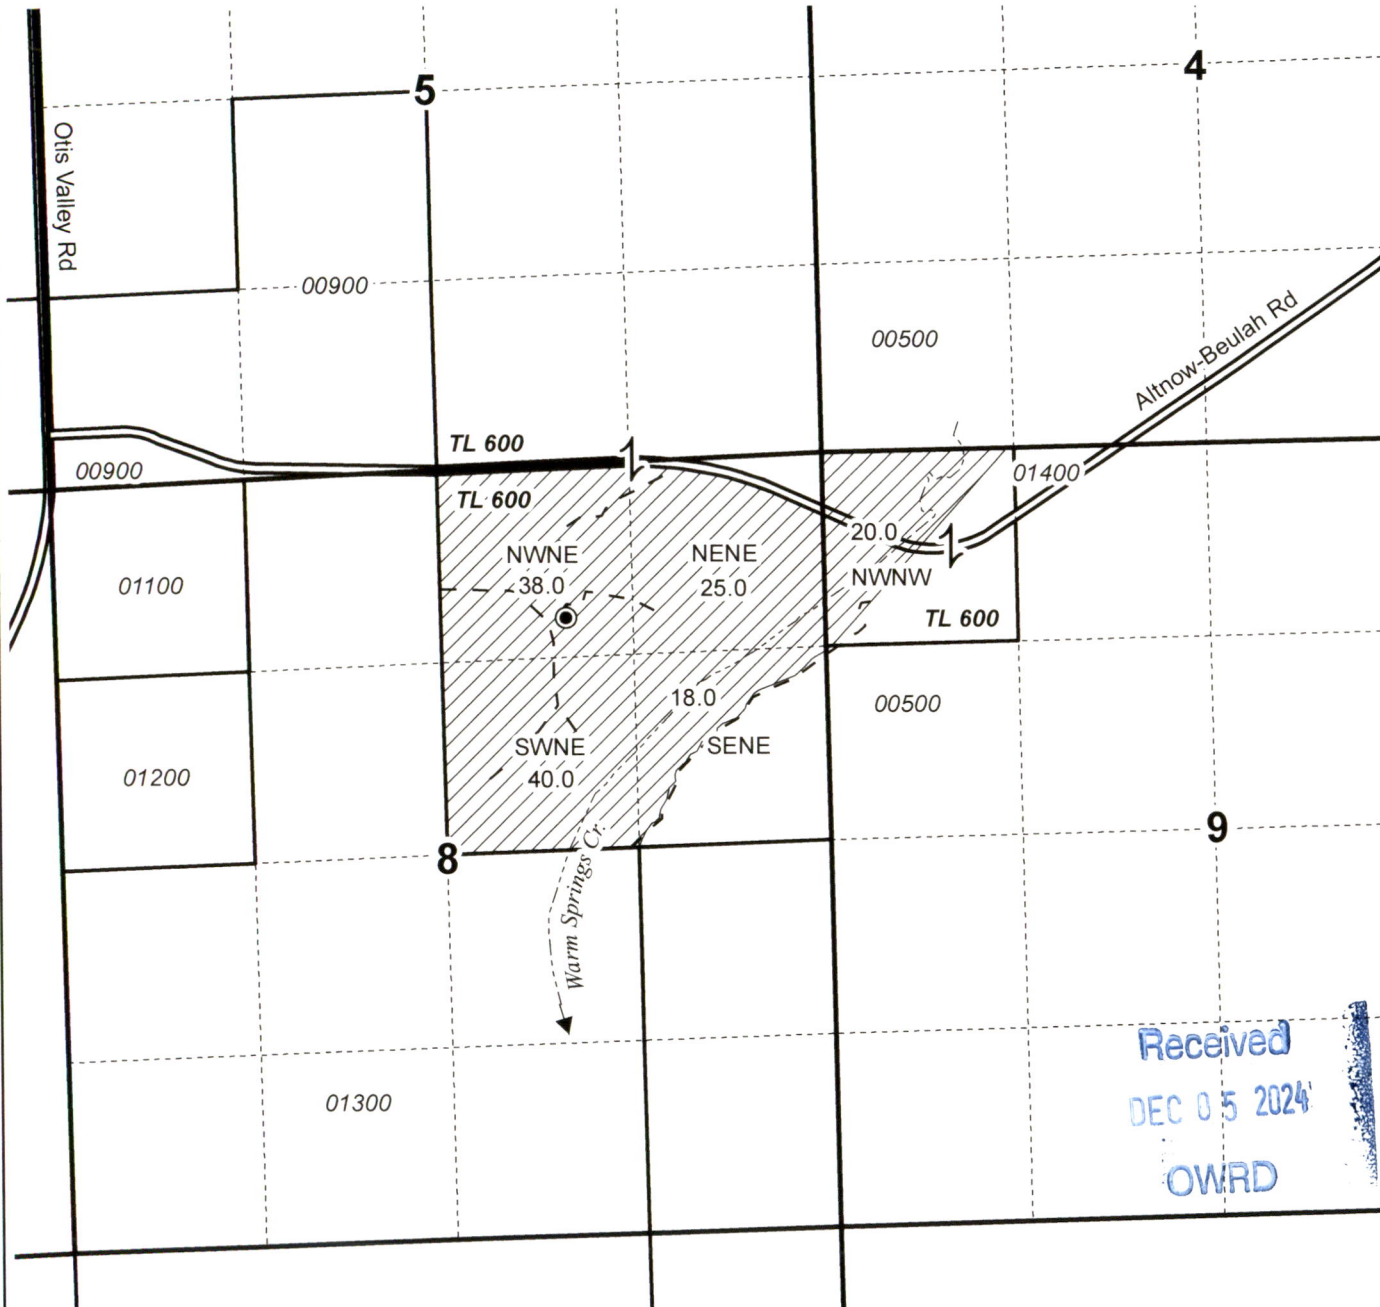

WATER RIGHT SERVICES, LLC
PO BOX 1830, BEND, OR 97709
WWW.OREGONWATER.US CCB # 197121
johnshort@usa.com 541-389-2837