

● POD, Pump, Fish Screen

□ Meter

----- Pipeline

▭ Section

----- DLC Line

----- Quarter Quarter

▭ Tax Lot

▨ Domestic Expanded Use

Received



AUG 04 2025

OWRD



RENEWS: 06/30/2026

T26S R4W, WM DOUGLAS COUNTY, OR

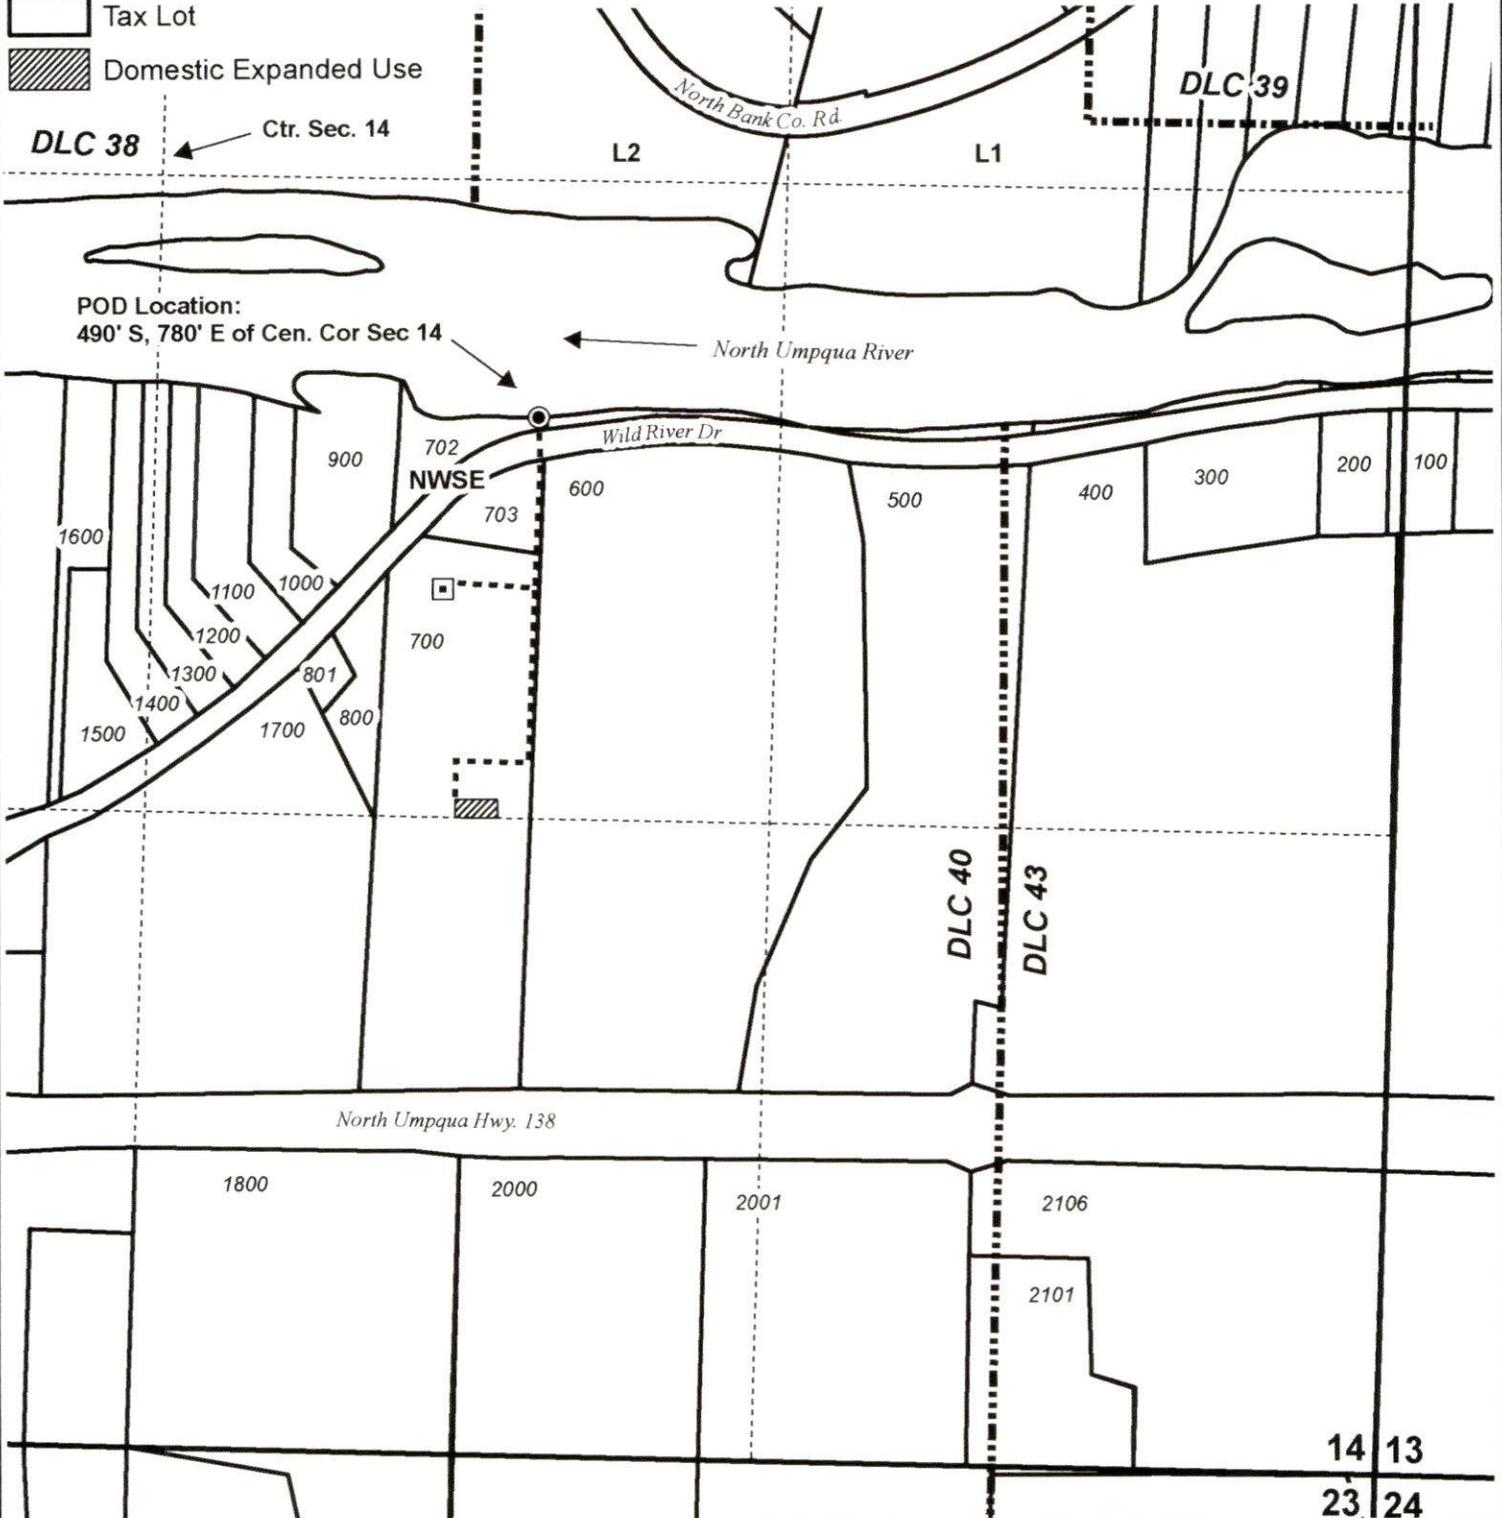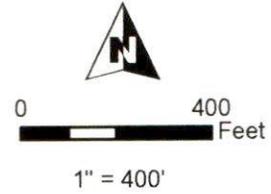

CLAIM OF BENEFICIAL USE MAP
Weber

Date: 7/22/2025 Ap S-87635 Permit S-54701

This map is not intended to provide legal dimensions or locations of property ownership lines.

WATER RIGHT SERVICES, LLC
PO BOX 1830, BEND, OR 97709
WWW.OREGONWATER.US CCB # 197121
brycewrs@gmail.com 541-389-2837