


T.3S. R.1E. Section 21, W.M.

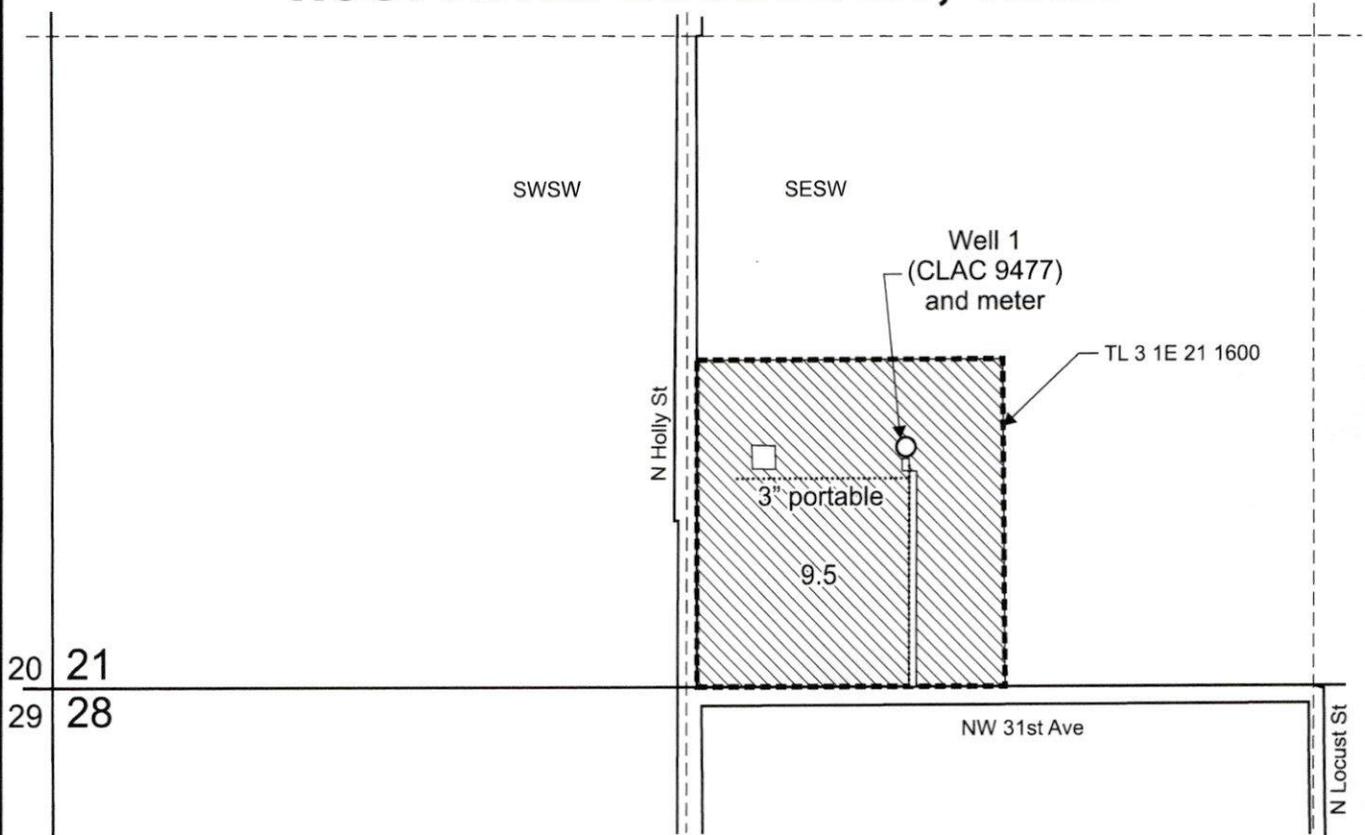

Well 1 (CLAC 9477) is located 490 feet north and 1,790 feet east from the SW corner, Section 21.

 Area (9.5 Acres) irrigated under Application G-17963, Permit G-18887, T-13985, T-14310

----- Tax lot boundary

..... Water main line are portable and can run different direction depending on the layout of the field.




Received by OWRD

JUN 02 2025

Salem, OR

Scale: 1" = 400'

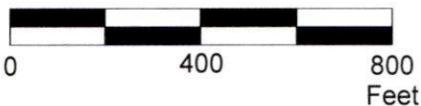

This map was prepared for the purpose of identifying the location of a water right only and is not intended to provide legal dimensions or location of property ownership lines.



Claim of Beneficial Use Map
Application G-17963, Permit G-18887, T-13985, T-14310

Pacific Hydro-Geology Inc.

Brendon and Heather Schloe
T.3S. R.1E. Section 21, W.M.

05/2025