



CLAIM OF BENEFICIAL USE MAP
APPLICATION R-84686, PERMIT R-13525
SECTION 12 & 13, TOWNSHIP 36 SOUTH, RANGE 2 WEST, W.M.
JACKSON COUNTY, OREGON

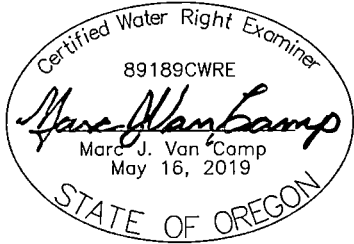

EXPIRES 06/30/2026

DISCLAIMER: THIS MAP WAS PREPARED FOR THE PURPOSE OF IDENTIFYING THE LOCATION OF WATER RIGHT ONLY AND IS NOT INTENDED TO PROVIDE LEGAL DESCRIPTIONS OR LOCATIONS OF PROPERTY LINES.

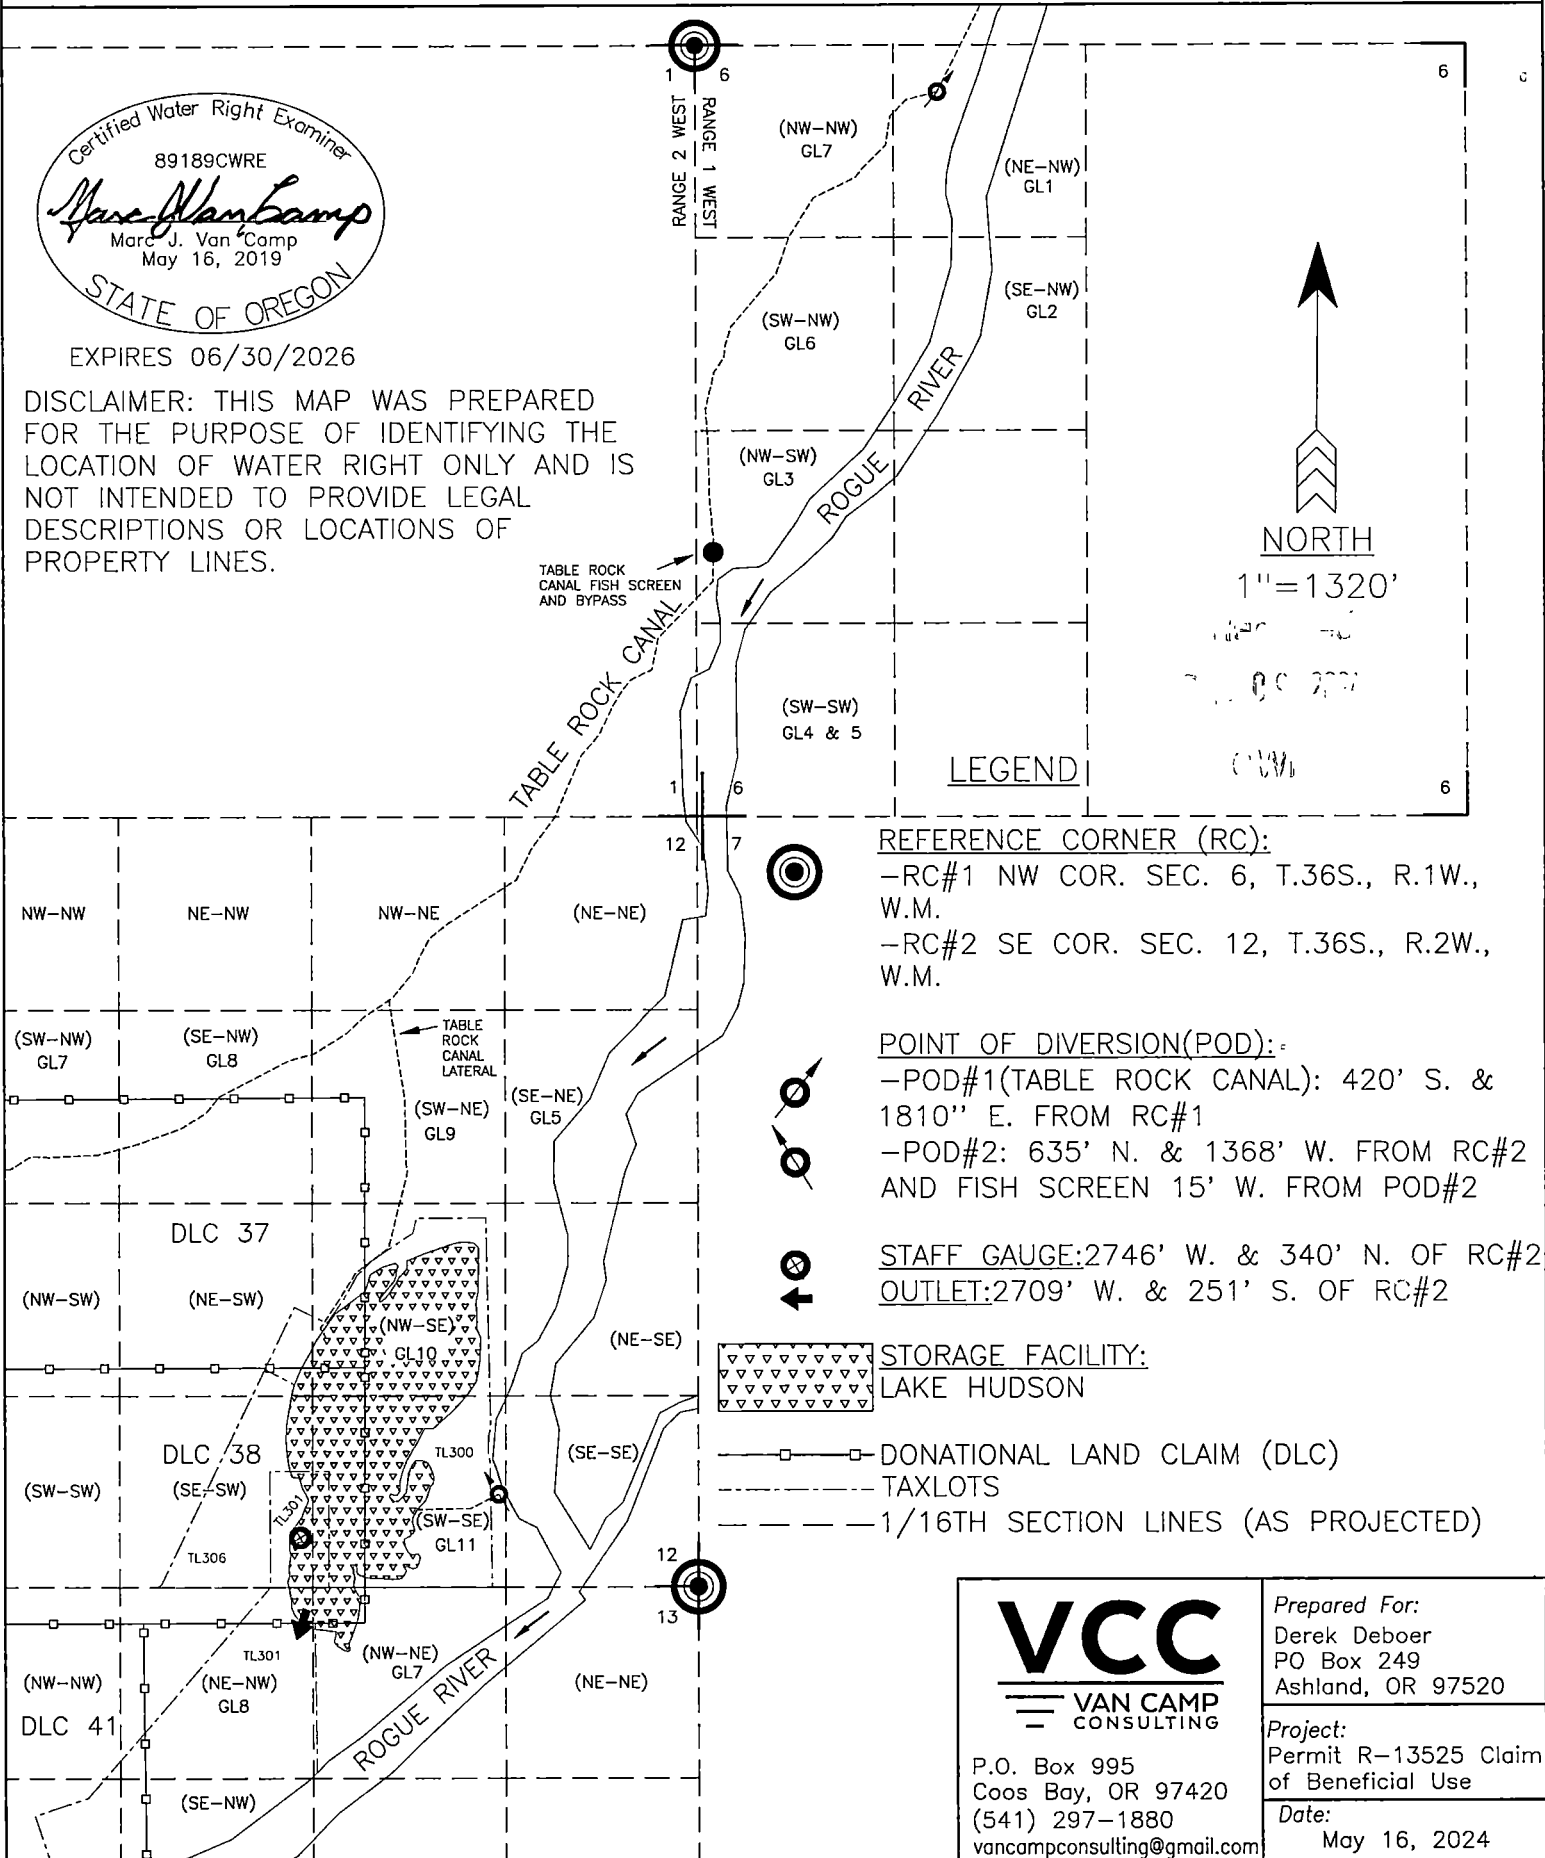

LEGEND

REFERENCE CORNER (RC):

- RC#1 NW COR. SEC. 6, T.36S., R.1W., W.M.
- RC#2 SE COR. SEC. 12, T.36S., R.2W., W.M.

POINT OF DIVERSION(POD):

- POD#1(TABLE ROCK CANAL): 420' S. & 1810' E. FROM RC#1
- POD#2: 635' N. & 1368' W. FROM RC#2 AND FISH SCREEN 15' W. FROM POD#2

STAFF GAUGE:2746' W. & 340' N. OF RC#2

OUTLET:2709' W. & 251' S. OF RC#2

STORAGE FACILITY:
LAKE HUDSON

- DONATIONAL LAND CLAIM (DLC)
- - - TAXLOTS
- - - 1/16TH SECTION LINES (AS PROJECTED)

VCC
VAN CAMP
CONSULTING

P.O. Box 995
Coos Bay, OR 97420
(541) 297-1880
vancampconsulting@gmail.com

Prepared For:
Derek Deboer
PO Box 249
Ashland, OR 97520

Project:
Permit R-13525 Claim
of Beneficial Use

Date:
May 16, 2024