


Proof Survey Map
Application S-84705, Permit 53887
T36S, R2W, Sec. 12 W.M.
DLC 38, SESW
Tax Lot 362W12-301

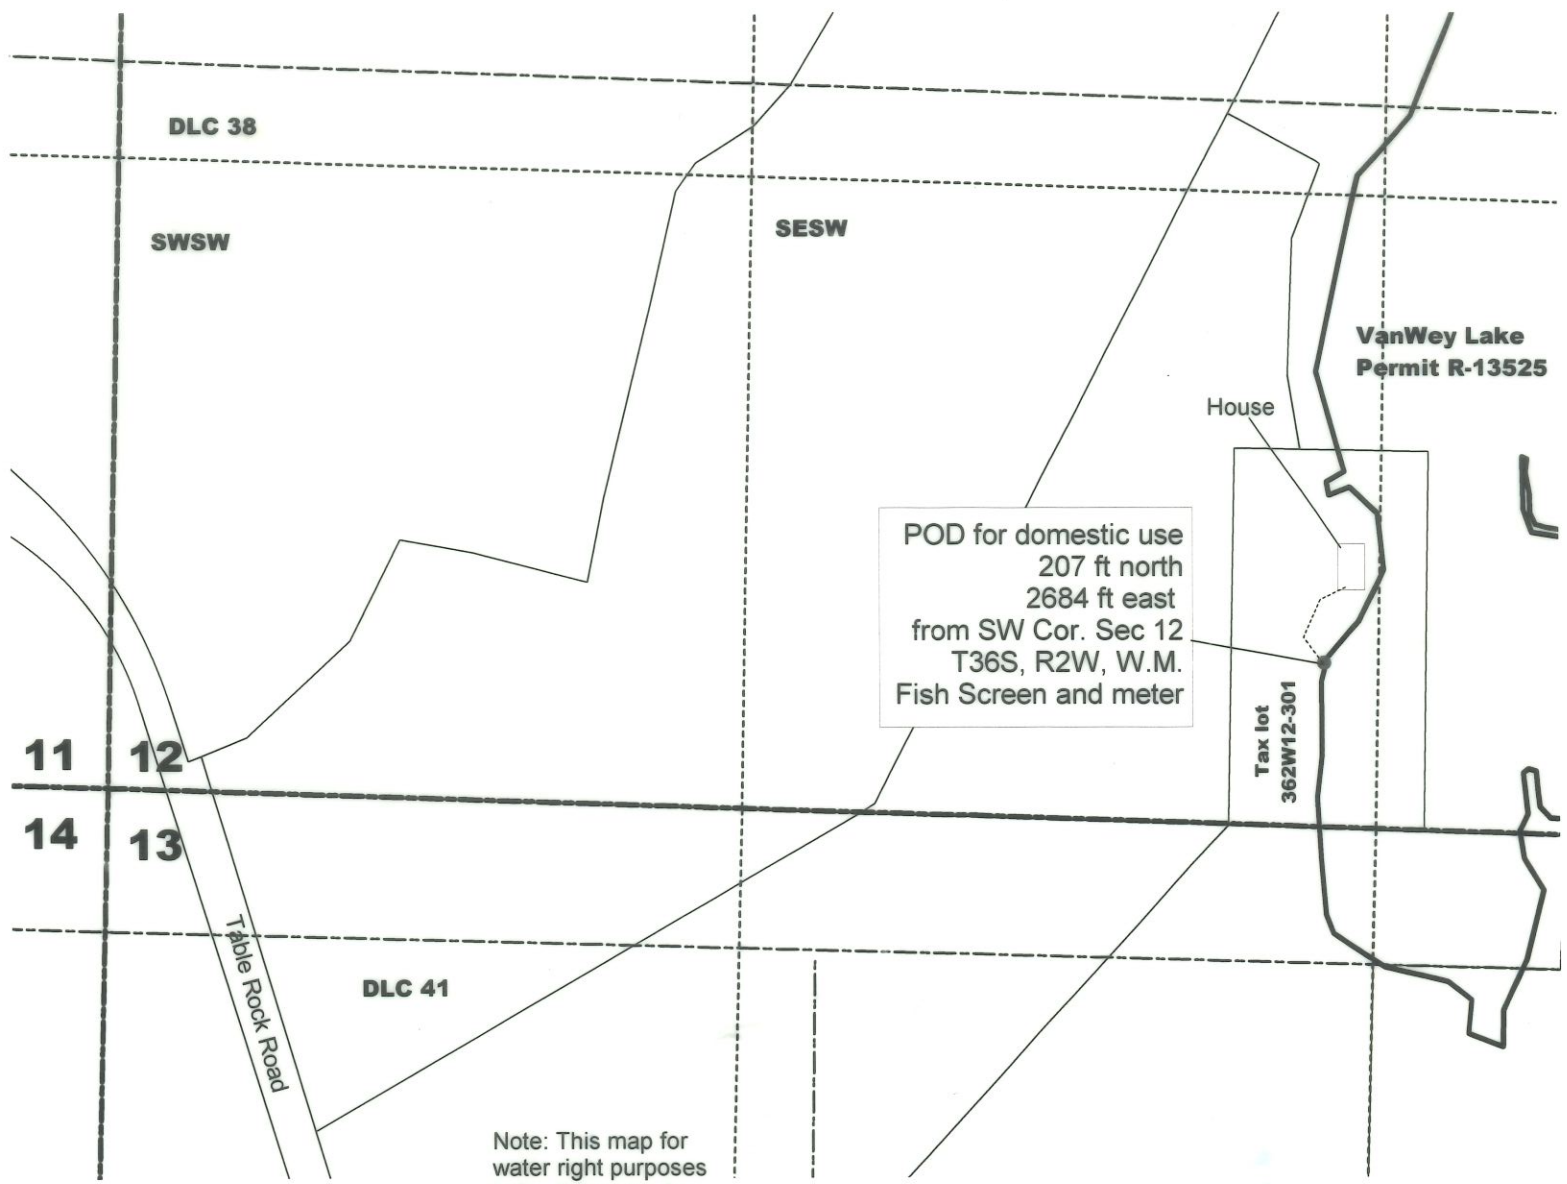

Note: This map for water right purposes only. It is not to be used for property line location.


Legend

- Domestic pipeline
- Section line
- Quarter-Quarter line
- DLC line



Scale 1" = 400'

RECEIVED
MAR 29 2007
WATER RESOURCES DEPT
SALEM, OREGON

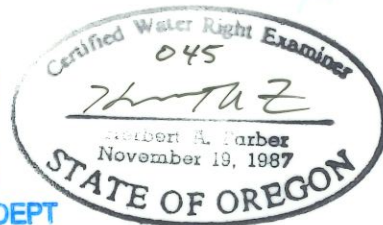

RENEWAL DATE 12-31-07

CWRE stamp