


CLAIM OF BENEFICIAL USE MAP

TO ADD POINTS OF APPROPRIATION AND PLACE OF USE FOR PERMIT APPLICATION G-17443-17519

SECTIONS 3 & 4, TOWNSHIP 22 SOUTH, RANGE 20 EAST, W.M.
TAX LOTS: 300, 500, 502, & 600




- 185.63 ACRES 'IR' FROM "SG" AND "DF" POAS, AS SHOWN.
- 105.69 ACRES 'IR' FROM "RC" POA, AS SHOWN.
- 113.58 ACRES 'IR' FROM "G2" POA, AS SHOWN.
- 131.10 ACRES 'IR' FROM "DT" POA, AS SHOWN.
- 105.65 ACRES 'IR' FROM "G1" POA, AS SHOWN.

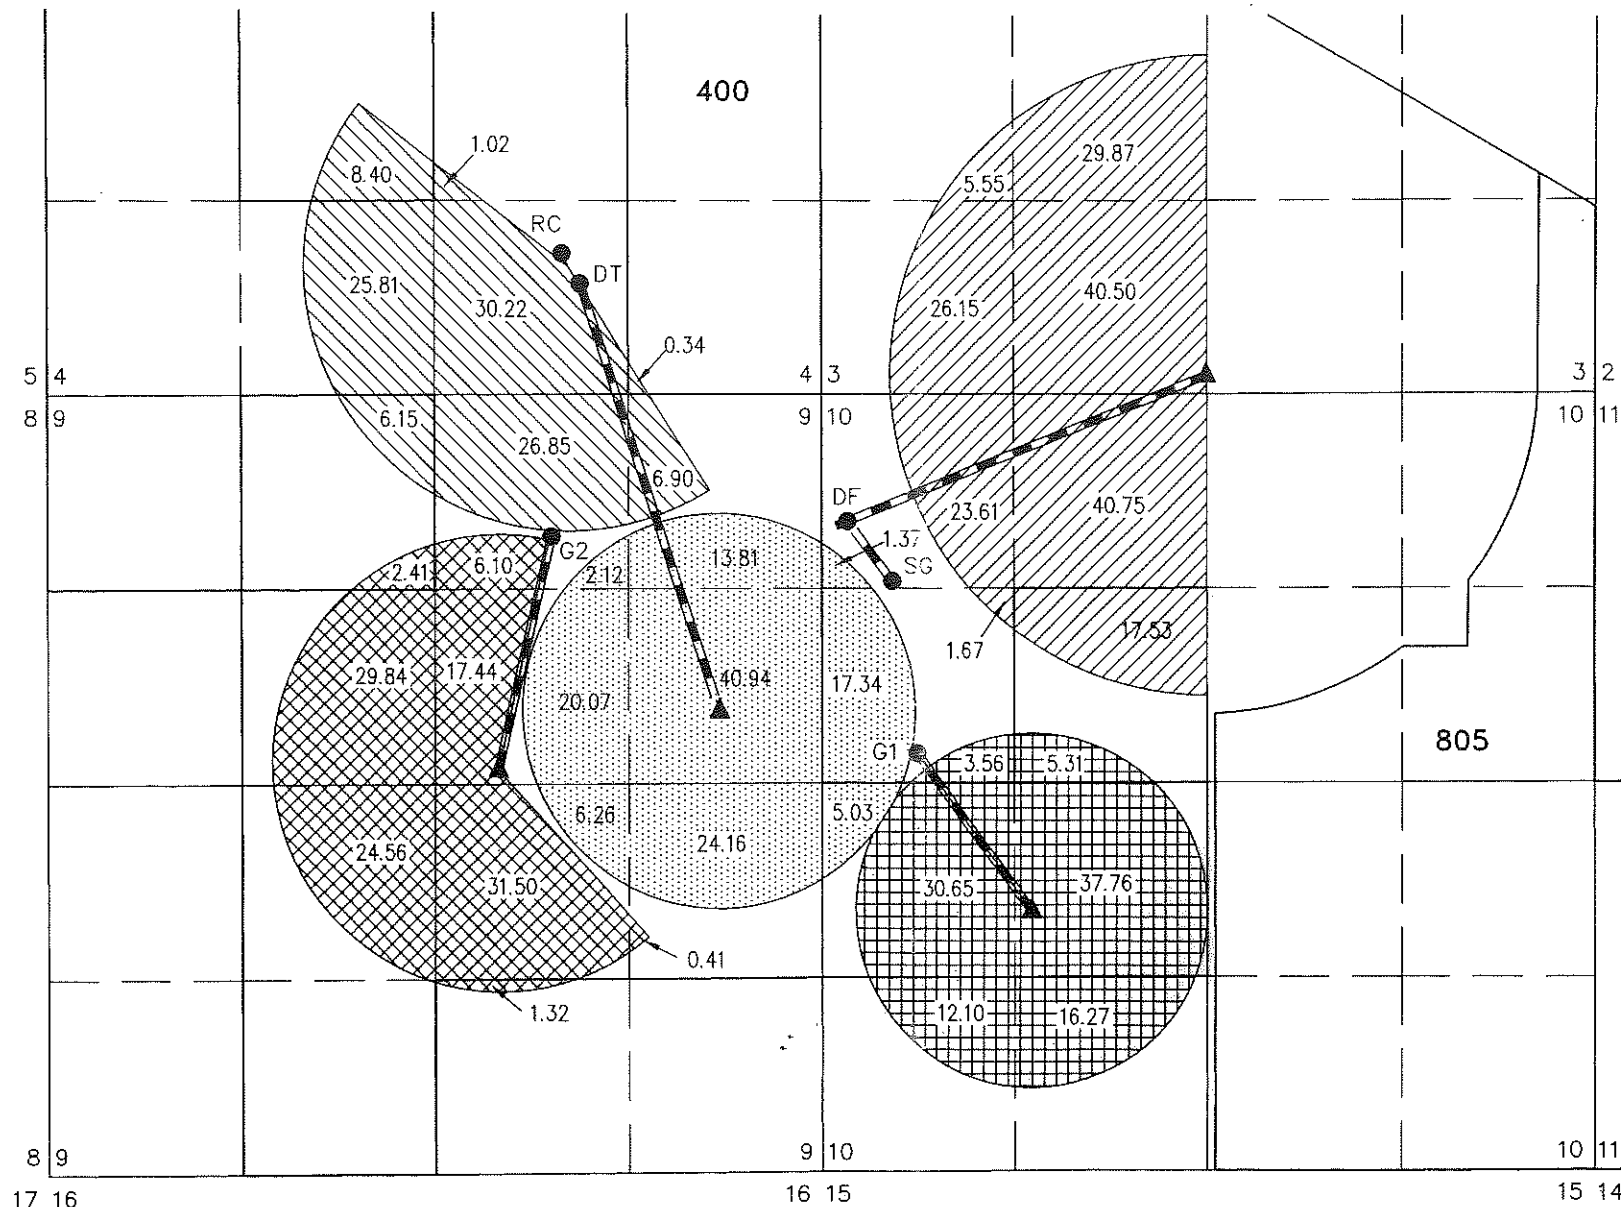

- GRAVEL PIT PIVOT 1 "G1"
(DESC 60543) LOCATED 2452' SOUTH & 651' EAST FROM THE NW CORNER SECTION 10. FLOW METER IS LOCATED 3 FEET NORTH FROM CENTER PIVOT.
- SAGE GROUSE "SG"
(DESC 60757) LOCATED 1278' SOUTH & 482' EAST FROM THE NW CORNER SECTION 10. FLOW METER IS LOCATED 6 FEET NW FROM WELL.
- DUSTY FLAT "DF"
(DESC 60756) LOCATED 870' SOUTH & 177' EAST FROM THE NW CORNER SECTION 10. FLOW METER IS LOCATED 3 FEET SOUTH FROM CENTER PIVOT.
- DIRT TANK "DT"
(DESC 60048) LOCATED 755' NORTH & 1655' WEST FROM THE SE CORNER SECTION 4. FLOW METER IS LOCATED 6 FEET WEST FROM CENTER PIVOT.
- ROCK CHUCK "RC"
(DESC 60049) LOCATED 960' NORTH & 1780' WEST FROM THE SE CORNER SECTION 4. FLOW METER IS LOCATED 9 FEET N FROM WELL.
- GRAVEL PIT PIVOT 2 "G2"
(DESC 60544) LOCATED 970' SOUTH & 1850' WEST FROM THE NE CORNER SECTION 9. FLOW METER IS LOCATED 5 FEET EAST FROM CENTER PIVOT.

▲ FLOW METER ON PIVOT

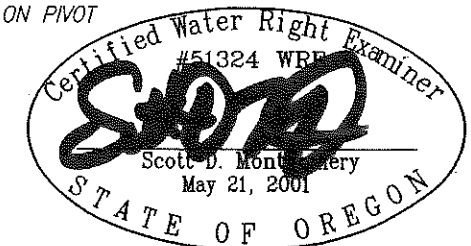

RENEWAL DATE: 12/31/2026

THIS MAP IS FOR THE PURPOSE OF LOCATING A WATER RIGHT ONLY AND HAS NO INTENT TO PROVIDE LEGAL DIMENSIONS OR THE LOCATION OF PROPERTY LINES

Received
JUN 23 2025
OWRT

PREPARED FOR:

DAVID BAKER
4010 S. HIGHWAY 20
BROTHERS, OR 97712

11/5/2025 un/wrd correction per email

PREPARED BY:



ALL POINTS ENGINEERING AND SURVEYING, INC.
P.O. BOX 767 TERREBONNE, OR 97760
(541) 548-5833 www.APEandS.com