


T.5S. R.1E. Section 9, W.M.

RECEIVED

MAR 27 2023

OWRD

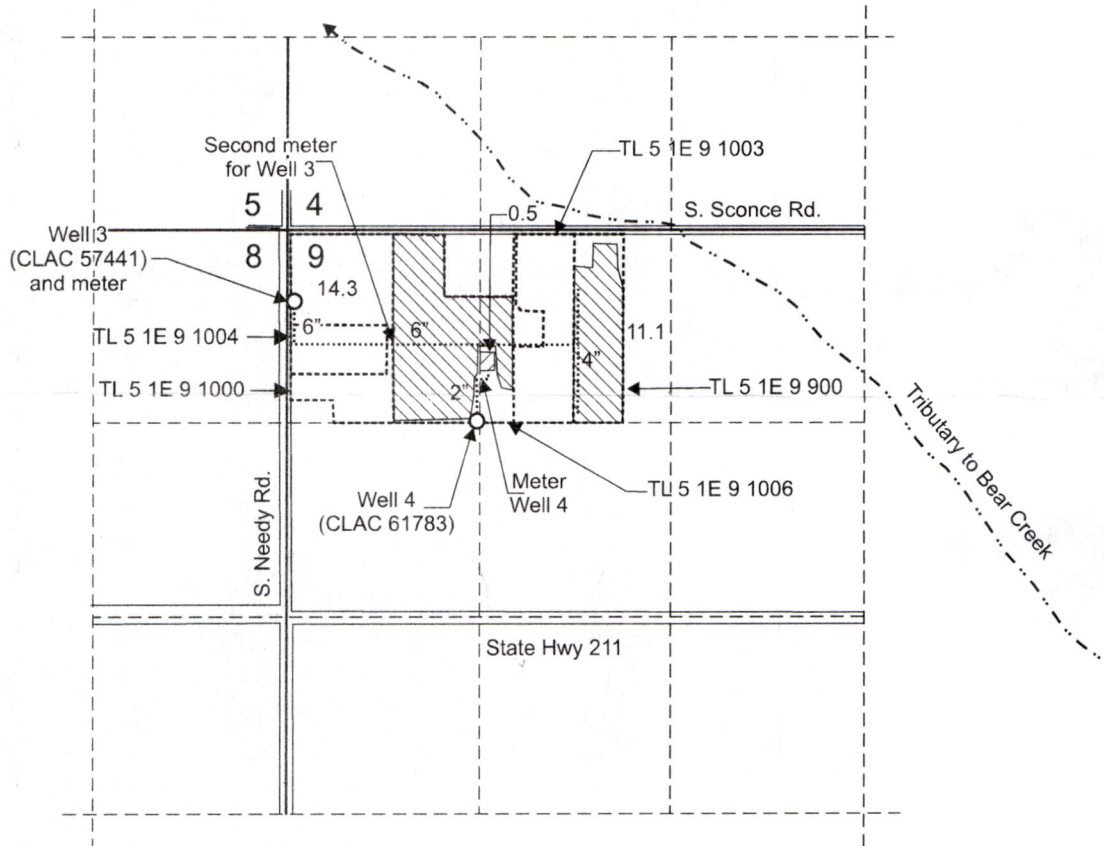

Well 3 (CLAC 57441) is located 480 feet south and 50 feet east from the NW corner of Section 9.

Well 4 (CLAC 61783) is located 1,290 feet south and 1,309 feet east from the NW corner of Section 9.

 Area (25.4 Acres) of nursery use for Application G-18186, Permit G-17785, using Well 3 only.

 Area (0.5 Acres) of nursery use for Application G-18186, Permit G-17785, using Well 4 only.

----- Tax lot boundary

..... Mainline



Scale: 1" = 1,320'



This map was prepared for the purpose of identifying the location of a water right only and is not intended to provide legal dimensions or location of property ownership lines.

Claim of Beneficial Use Map
Application G-18186, Permit G-17785

Pacific Hydro-Geology Inc.

01/2023

David Sather
T.5S. R.1E. Section 9, W.M.