
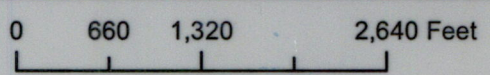


Claim of Beneficial Use - WK and K Land LP

Application G-18217, Permit G-17980

Township 11S, Range 4W, W.M.

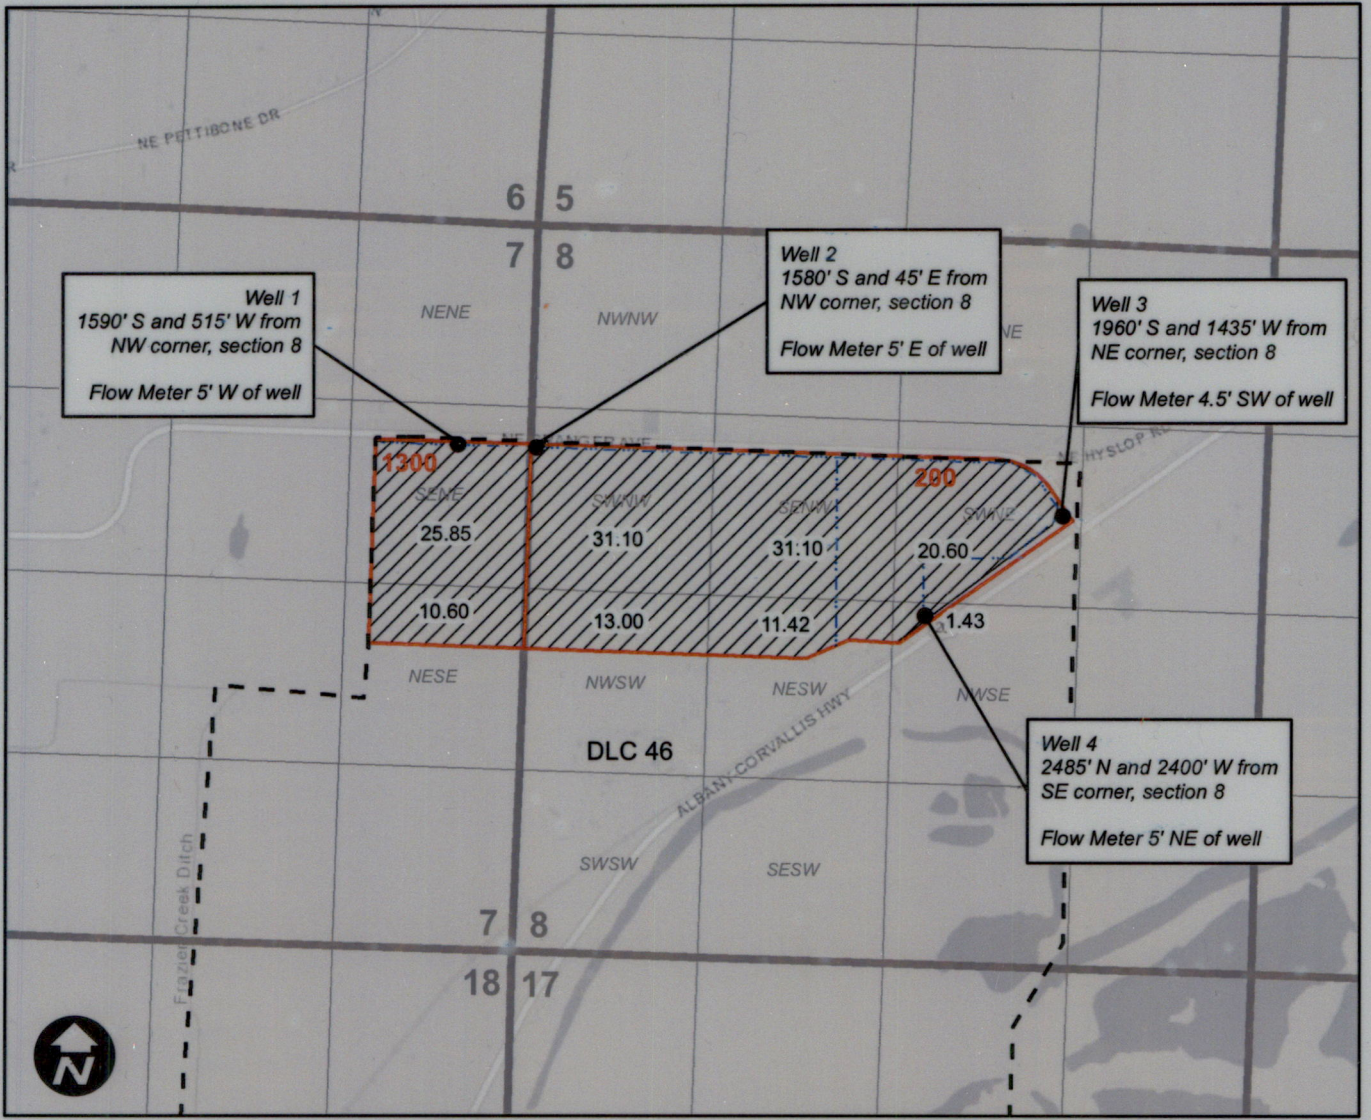

This map is not intended to provide legal dimensions or locations of property ownership lines.

Legend

- POU
- Taxlot
- Mainline
- DLC



Received by OWRD

JAN 30 2024

Salem, OR

EXPIRES: 12-31-2024