

T.5S. R.1E. Section 11, W.M.

RECEIVED

JAN 25 2012

ROAD

C1/4 Corner,
Section 11

SENW
NESW

Highway 211

South Dryland Road

33.6 Under the
highway

Well 1
(CLAC 76948)
and meter

TL 5 1E 11 1000

Well 1 (CLAC 76948) is located 730 feet south and 1,305 feet east from the C1/4 Corner, Section 11.




Area (33.6 acres) of irrigation under Application G-18299, Permit G-17790.



Tax lot boundary



Scale: 1" = 400'

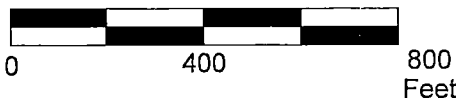

This map was prepared for the purpose of identifying the location of a water right only and is not intended to provide legal dimensions or location of property ownership lines.



Claim of Beneficial Use Map
Application G-18299, Permit G-17790

Pacific Hydro-Geology Inc.

Kiprian and Anna Tipikin

