


CLAIM OF BENEFICIAL USE MAP
For
SURFACE WATER APPLICATION S-88210 & PERMIT S-55011
PERMIT AMMENDMENT T-11435 (Purpose)



DONATION LAND CLAIM 48
Sections 27 & 28, Township 5 South, Range 4 West of WM


STEVEN M. & ROSALBA M. GOFFENA PROPERTY

Property: 6055 SE Eola Hills Road
Amity, Oregon

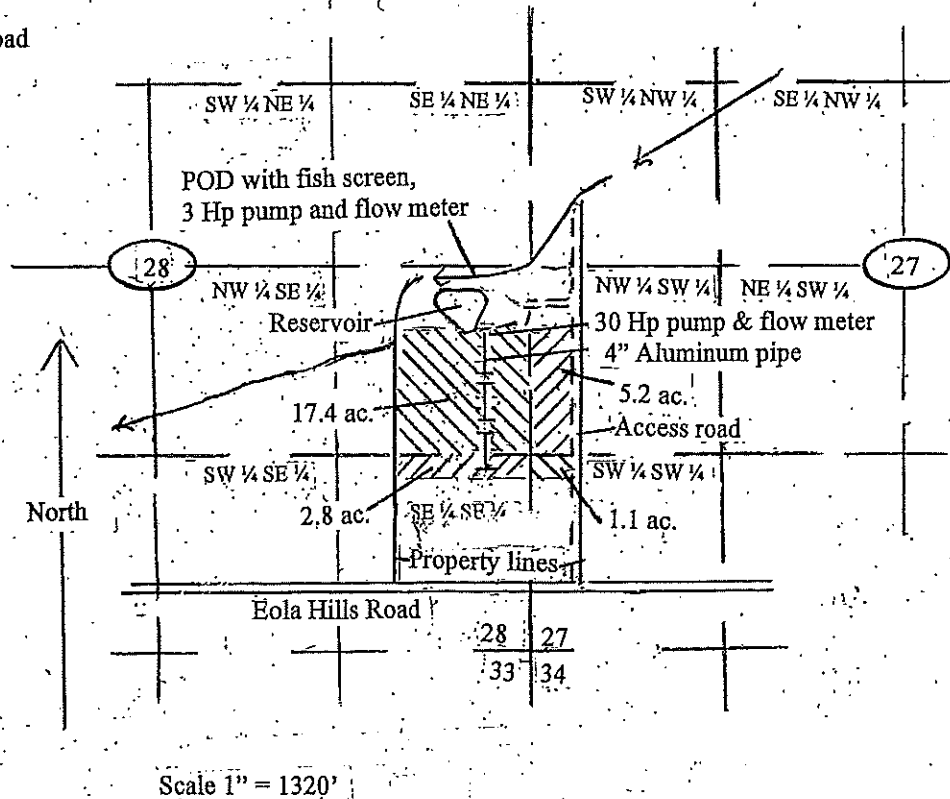

POD 350' West and 50' South of East 1/4 Corner Section 28
(45° 06.5' North Latitude and 123° 10.6' West Longitude)

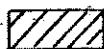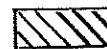  Irrigated area under Multipurpose use

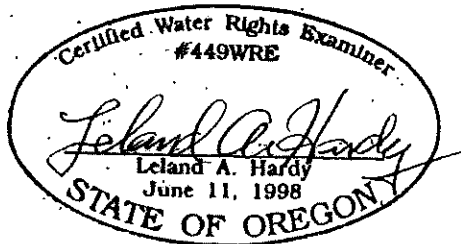

RENEWAL DATE: 6/21

The purpose of this map is to identify the location of an existing POD and water use. It is not intended to provide information relative to the location of property ownership boundary lines.