


- LEGEND**
- Point of Appropriation (POA)
 - Flowmeter
 - Water Conveyance
 - Place of Use (POU)
 - Tax Lot
 - Government Lot (GL)
 - Donation Land Claim (DLC)
 - Railroad
 - Watercourse
 - Waterbody

**Claim of Beneficial Use Map
A Water Right in the Name of
George and Susan Hansen
Permit G-16429, Application G-16991
Section 4, Township 5 South, Range 3 East (W.M.)**

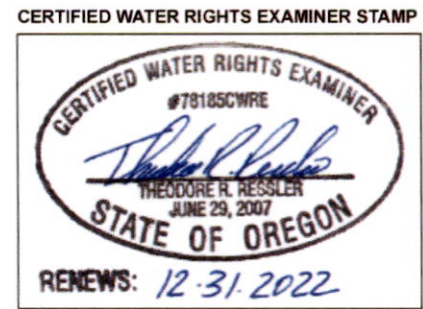

RECEIVED
SEP 08 2021
OWRD

LOCATION DESCRIPTION
Well 1 (CLAC-65759)
Located 2,460 feet North and 390 feet East from the SW corner of Section 4, Township 5 South, Range 3 East (W.M.)

DISCLAIMER
This map was prepared for the purpose of identifying the location of a water right only and it is not intended to provide legal dimensions or location of property ownership lines.
Date: August 23, 2021
Data Sources: BLM, ESRI, OWRD, USGS

