


RECEIVED

DEC 16 2022

CWRD
SALEM, OREGON

T.13S., R.33E., W.M.

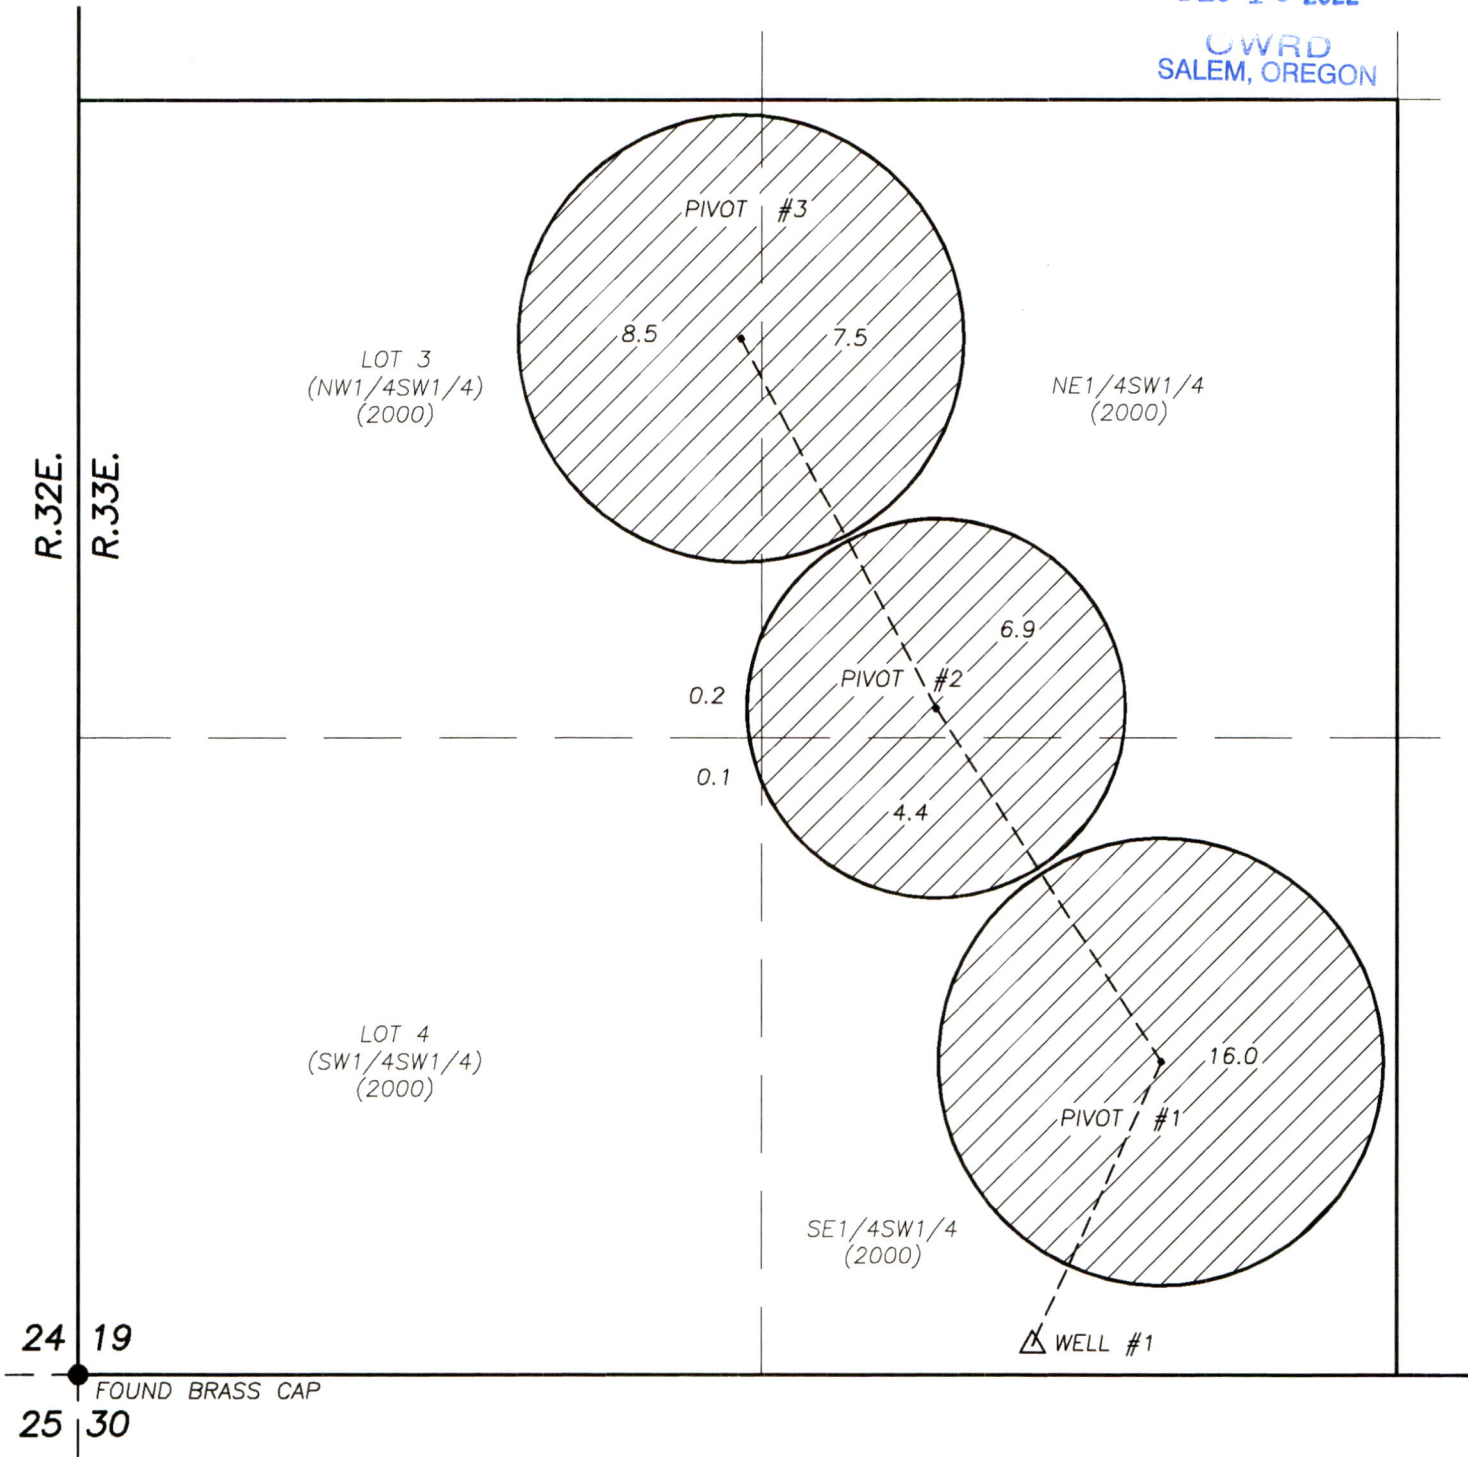

SCALE: 1" = 400'

CLAIM OF BENEFICIAL USE MAP
UNDER
APPLICATION G-16980
PERMIT G-16471
IN NAME OF
SAM McDANIEL

PREPARED BY:
ROBERT D. BAGETT, PLS, CWRE
217 N. CANYON BLVD.
JOHN DAY, OREGON
(541) 575-1251
AUGUST 17, 2022

- △ POA- WELL #1 & FLOW METER: 62' NORTH & 1982' EAST FROM THE SW CORNER SEC. 19, T.13S., R.33E., W.M.
- ▨ SUPPLEMENTAL IRRIGATION
- PIPELINE
- () TAX LOT NO.

