



CODU MAP # 1286

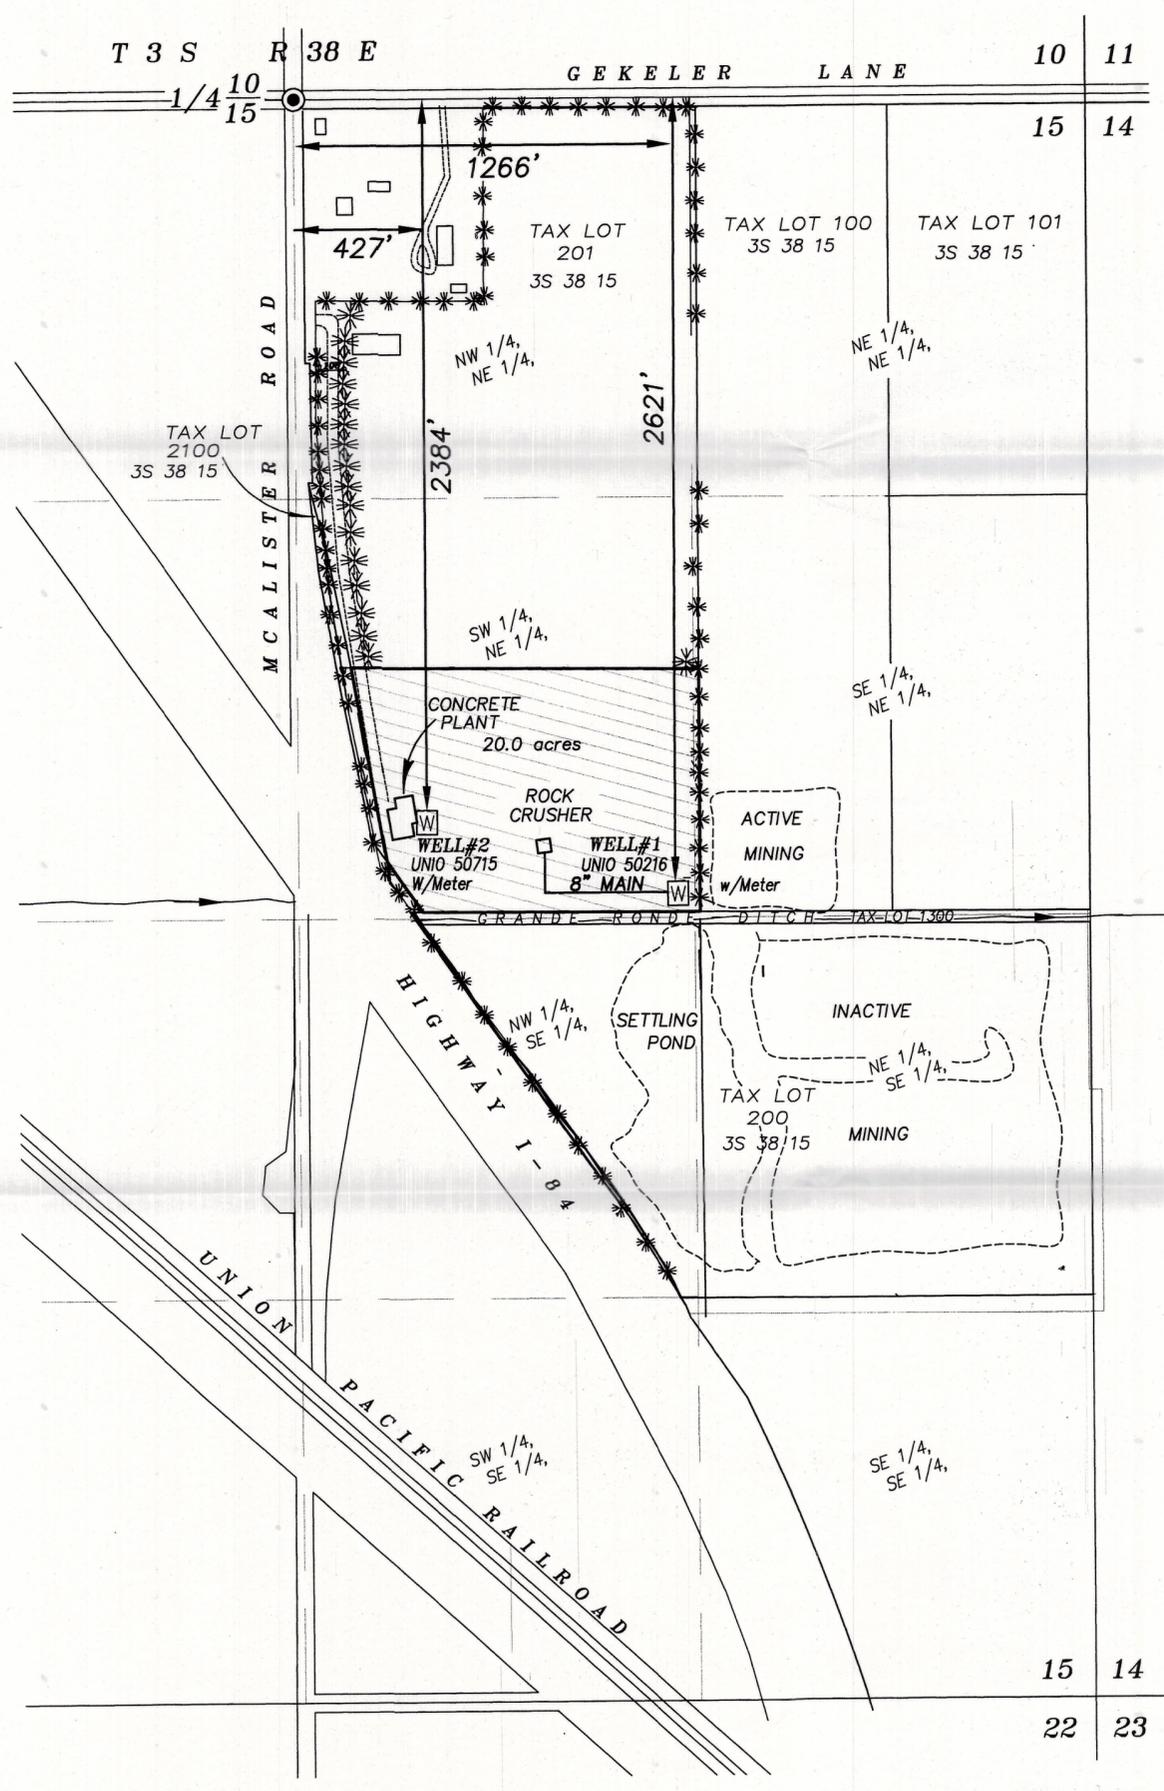

N

SCALE: 1"=400'

LEGEND

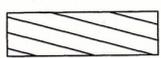-  Lands requesting aggregate mining water from existing Well for washing aggregate during processing
-  Well
-  Existing Tree For Screening



Renews: June 30, 2021

NOTE: The preparation of this map was for the purpose of identifying the location of the proposed water right and has no intent to provide dimensions or location of property ownership lines. Location information shown hereon was furnished by the applicant.

CLAIM OF BENEFICIAL USE FOR  
AGGREGATE MINING FROM  
TWO EXISTING WELLS UNDER  
PERMIT G-18469  
FOR  
R.D. MAC INC  
BY  
BAGETT, GRIFFITH AND BLACKMAN  
2006 ADAMS AVE  
LAGRANDE, OREGON 97850

March 10, 2021  
APPLICATION NO. G-18577  
PERMIT NUMBER G-18469

**RECEIVED**  
**APR 19 2021**  
**OWRD**