


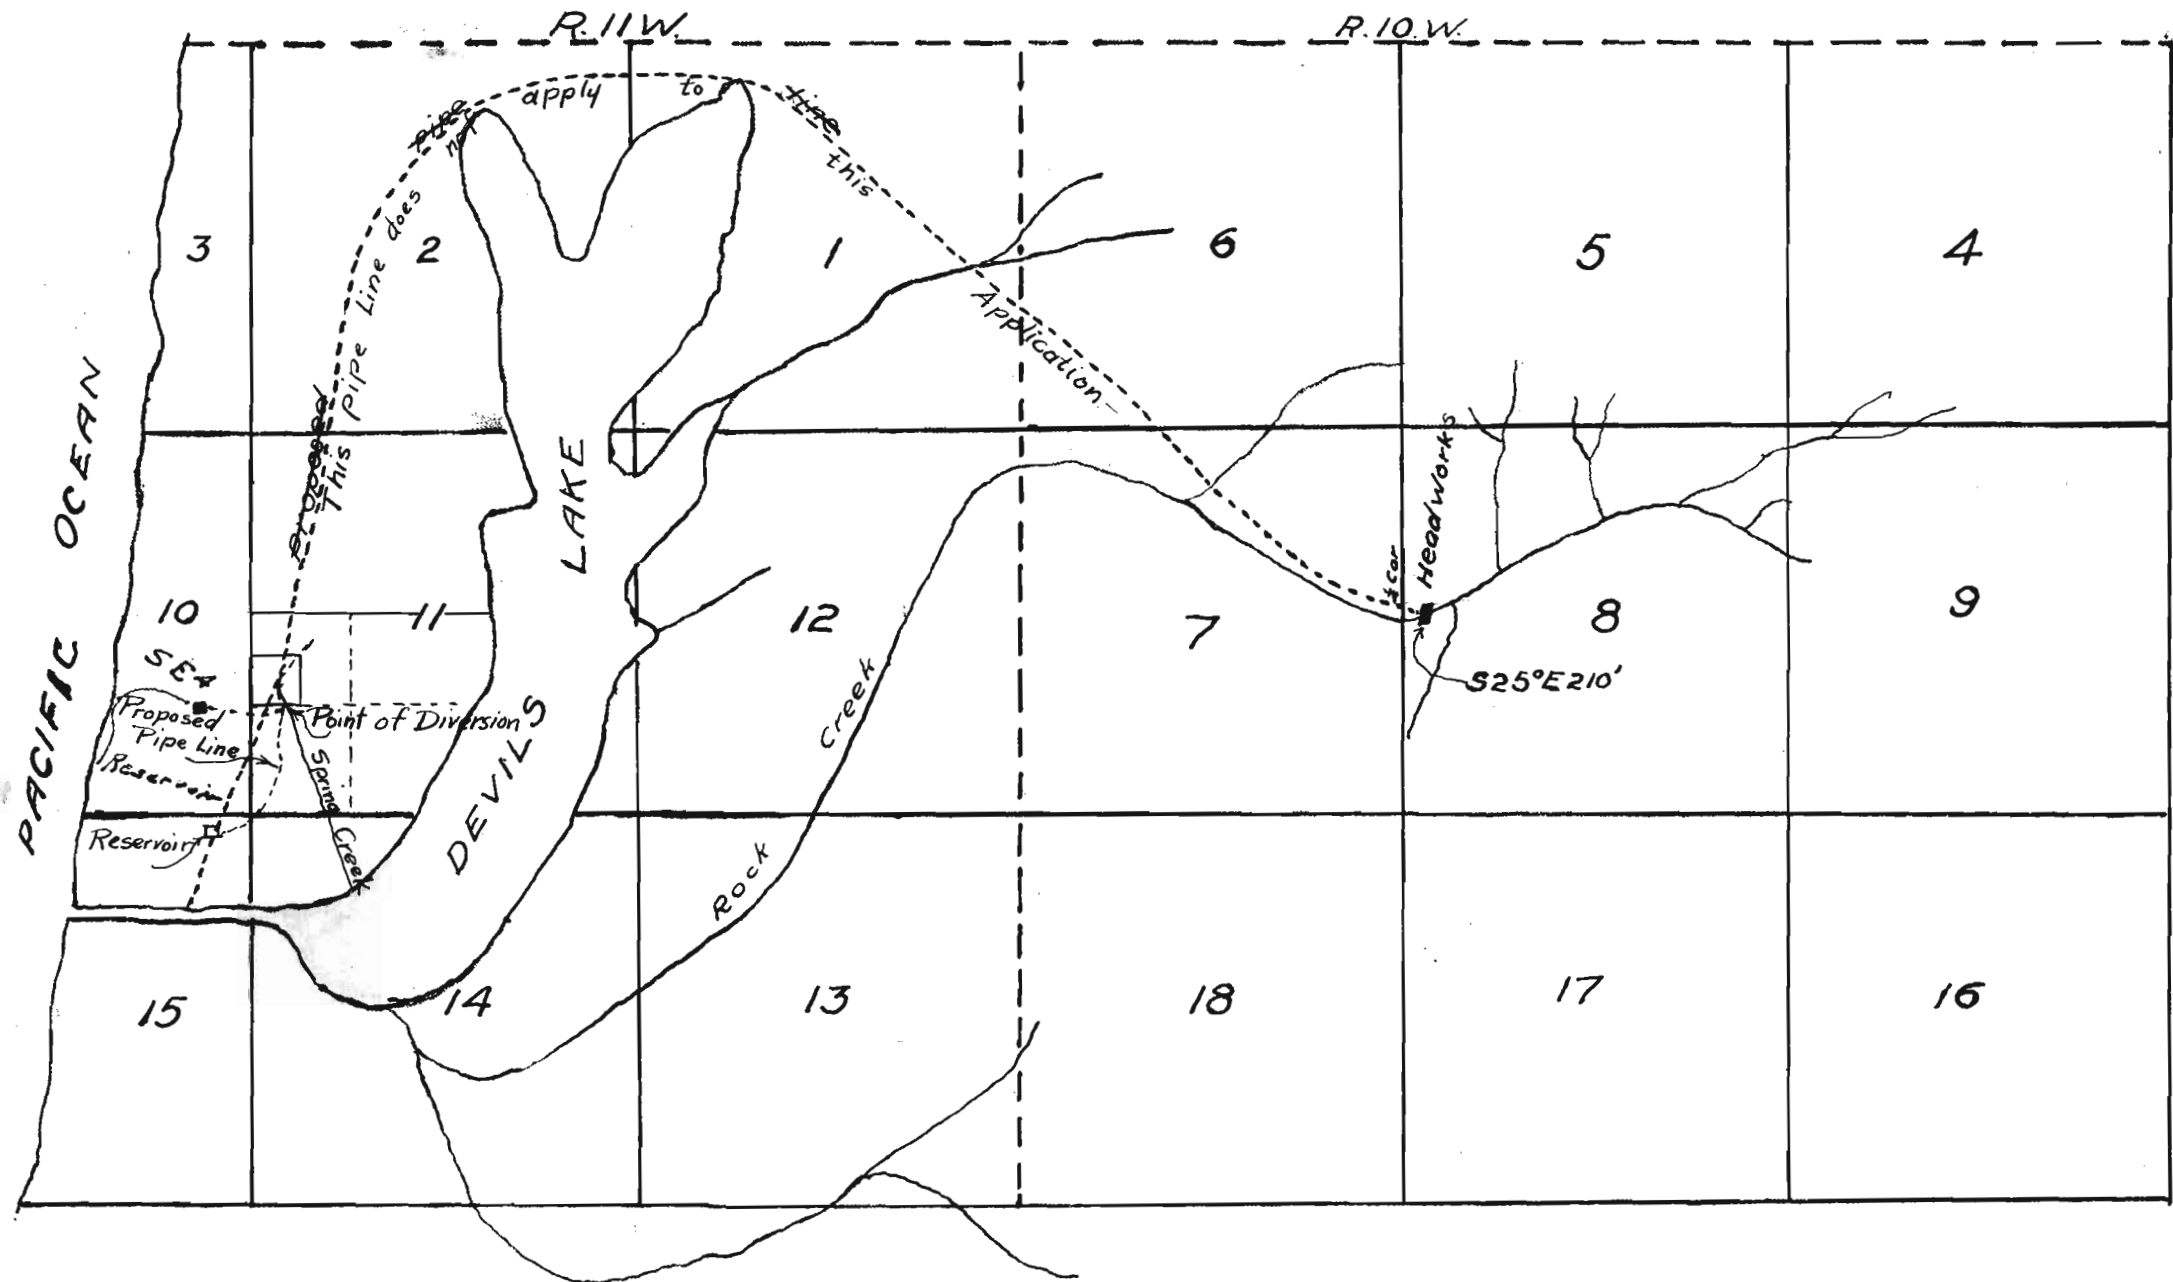

MAP SHOWING LOCATION OF
PROPOSED HEADWORKS AND PIPE LINE
FOR WATER SUPPLY
FOR COMUNITY OF DEVILS LAKE

I R.W. Jones of McMinville do hereby certify that
this map was made from notes taken during
an actual survey made by me on October 3-1926
and that correctly represents the works described
in the accompanying application together with
the location of streams and other bodies of water in
the immediate vicinity

R.W. Jones
Registered Professional Engineer
Oregon No 793 Date March 8-1926

Application No.
Permit No.

100711
779