


CLAIM OF BENEFICIAL USE
APPLICATION G-18602 PERMIT G-18484
SECTION 29, T 22 S, R 8 W, WM.
DOUGLAS COUNTY, OREGON

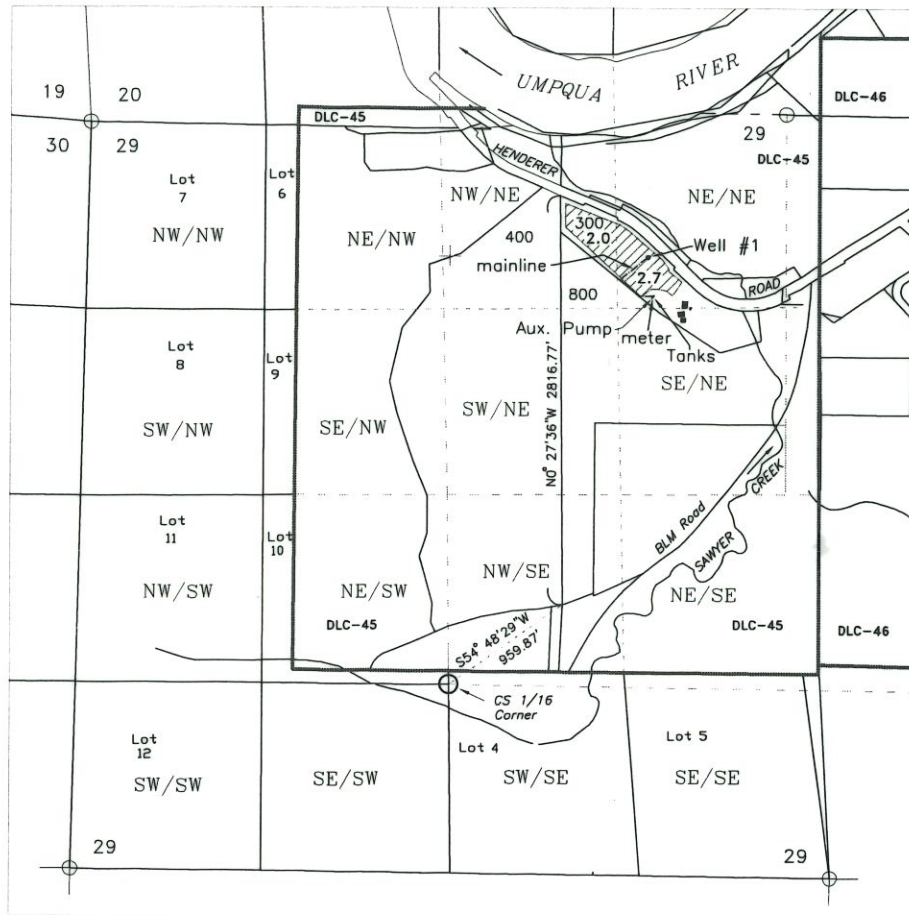

LEGEND

Well-1 NE/NE, DLC-45, 2950 feet North & 1365 feet East from the Center South 1/16 Corner, Section 29

PREPARED FOR:


James J. Wood
Tuckaway Vineyard
5830 Henderer Road
Elkton, OR 97436



Irrigation 4.7 Ac.
Tax Lot 300



Buildings

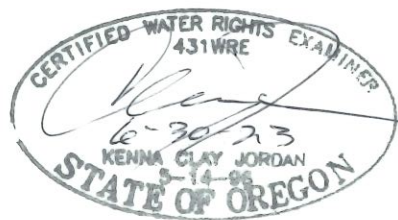

Scale

1" = 1320'

JORDAN ENGINEERING
460 JORDAN LANE
ROSEBURG, OR 97471
(541) 673-1931

Base maps, Douglas County GIS Tax Lots oriented & adjusted to survey maps M87-33, M-138-59 & M8-77 over current Oregon Map aerial photo & 4-29-19 Google aerial photo for assumed best fit

This map is not intended to provide legal dimensions or locations of property ownership lines

7/20/2021 N.E.D.