



CLAIM OF BENEFICIAL USE MAP

TO CHANGE PLACE OF USE AND
A POINT OF APPROPRIATION
FOR APP T-7136
RYAN & JENNIFER RENNER

SECTION 21, TOWNSHIP 25 SOUTH, RANGE 14 EAST, W.M.
TAX LOT: 1201 LAKE COUNTY, OREGON

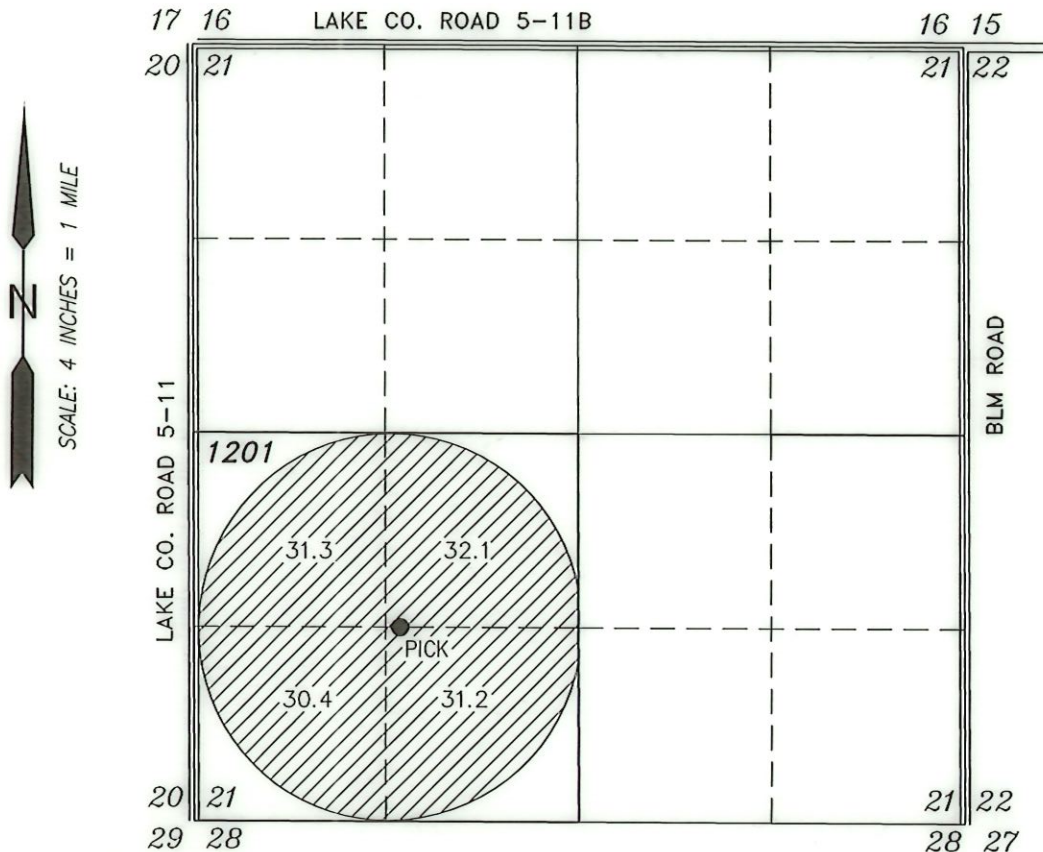

Received
NOV 03 2025
OWRD

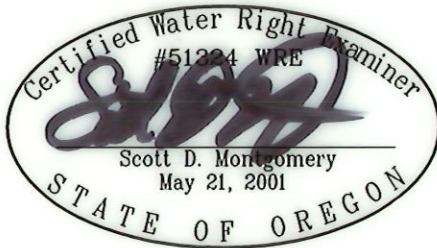

RENEWAL DATE: 12/31/2026

125.0 ACRES FROM PICK
WELL & T-7136, AS SHOWN

- #1 (PICK WELL)
EXISTING WELL (LAKE 4334/50289)
TRANSFER: T-7136
LOCATED S 46°33'11" E 1947.69' FROM 1/4
CORNER COMMON TO SECTIONS 20 & 21.

THIS MAP IS FOR THE PURPOSE OF LOCATING A WATER
RIGHT ONLY AND HAS NO INTENT TO PROVIDE LEGAL
DIMENSIONS OR THE LOCATION OF PROPERTY LINES

THIS MAP WAS CREATED USING THE CLAIM MAP RECEIVED
FROM CARL SUNDET, CWRE #117 ON 9/20/2000 FOR
T-7136. NO FIELD VISIT WAS MADE BY MYSELF.

PREPARED FOR:


RYAN & JENNIFER RENNER
P.O. BOX 31
FORT ROCK, OR 97735

PREPARED BY:



ALL POINTS ENGINEERING AND SURVEYING, INC.
P.O. BOX 767 TERREBONNE, OR 97760
(541) 548-5833 www.APEandS.com

MAP TO ACCOMPANY
CLAIM OF BENEFICIAL USE
FOR A PORTION OF TRANSFER T-7136
LOCATED IN SECTION 21
TOWNSHIP 26 SOUTH, RANGE 15 EAST, W.M.
LAKE COUNTY, OREGON

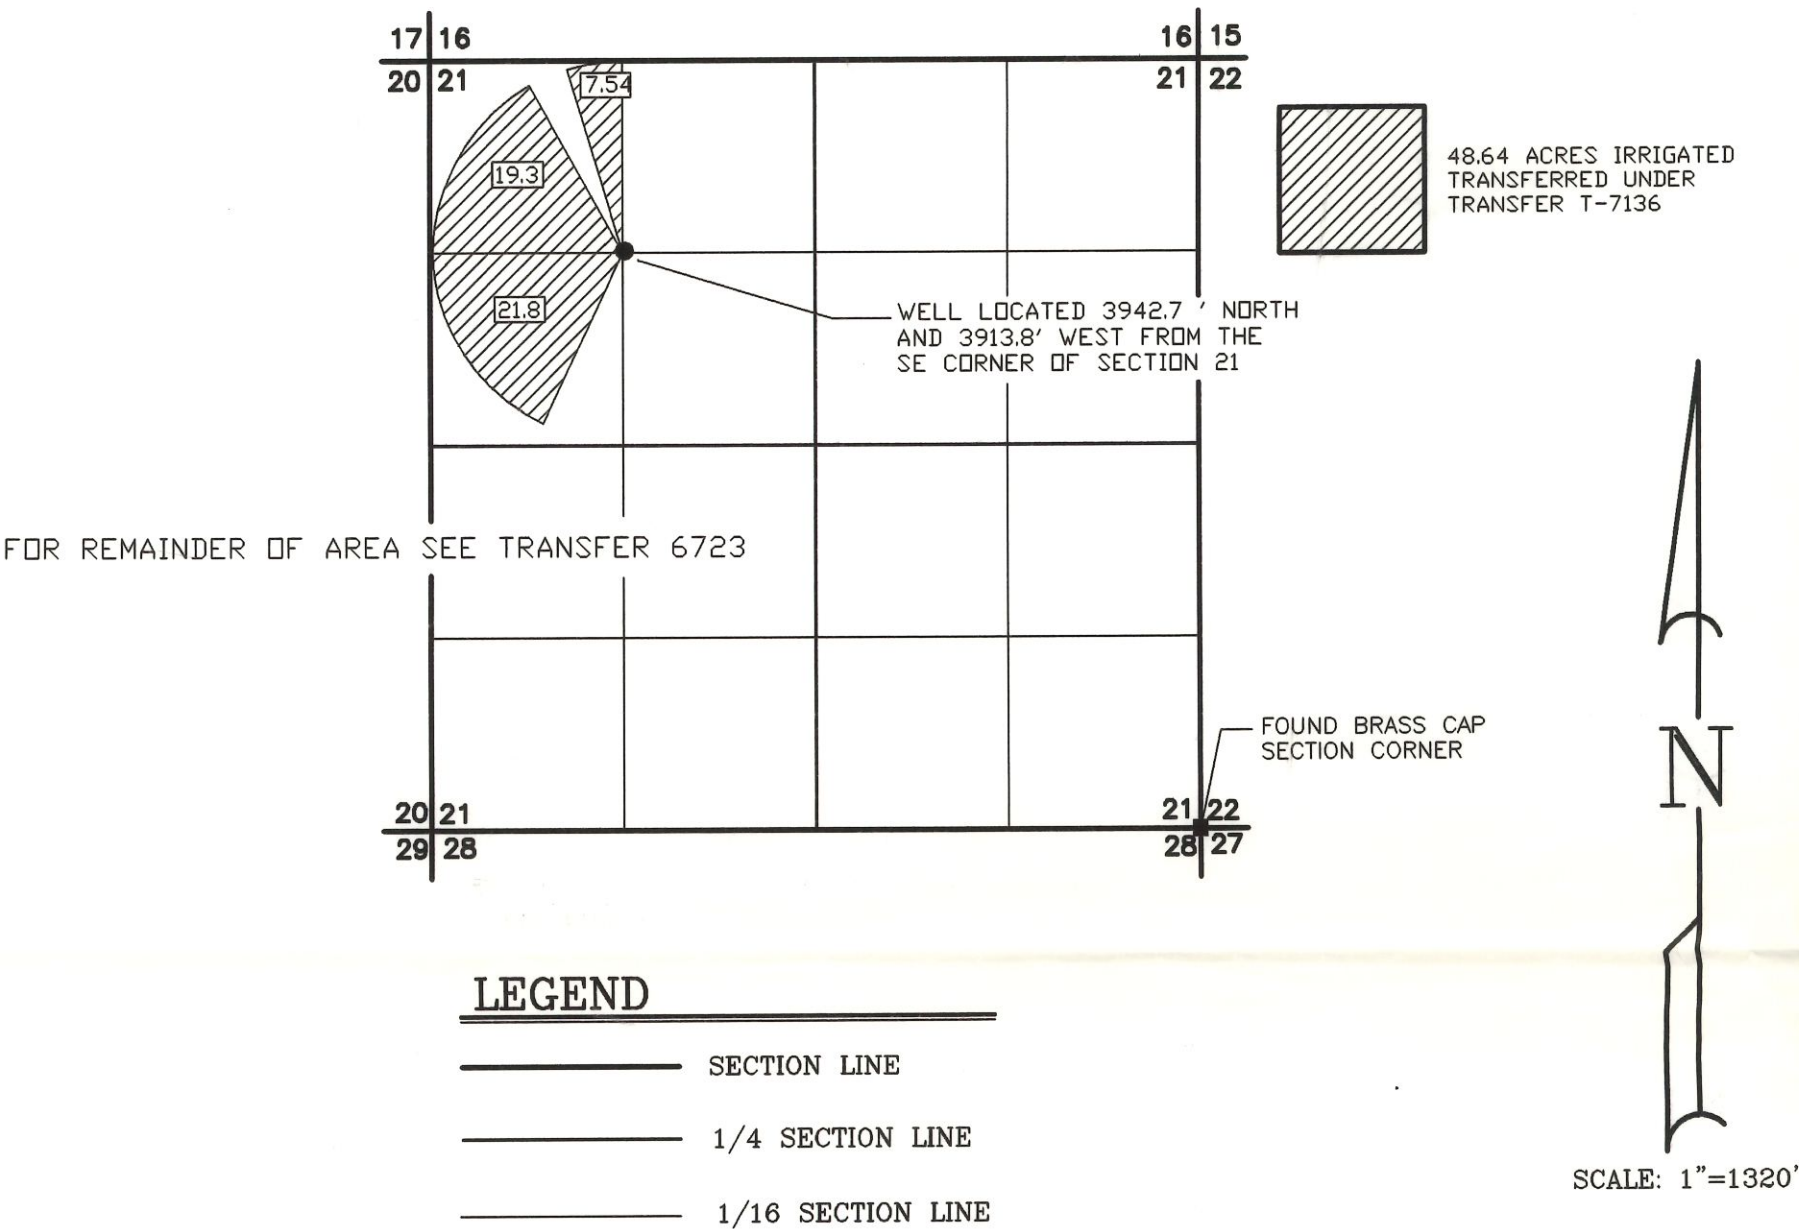

NOTE: PREPARATION OF THIS MAP IS FOR IDENTIFYING PROPOSED
WATER RIGHTS ONLY. IT HAS NO INTENT TO PROVIDE LOCATIONS
OR DIMENSIONS OF PROPERTY BOUNDRIES..

RECEIVED
DEC 05 2003
WATER RESOURCES DEPT
SALEM, OREGON

Certified Water Right Examiner
005
Darryl J. Anderson
Nov. 19, 1987
STATE OF OREGON
RENEWAL 12/31/03

PREPARED FOR:
SAM DINSDALE
57673 FORT ROCK ROAD
SILVER LAKE, OR 97638

PREPARED BY:
ANDERSON ENGINEERING & SURVEYING, INC.
P.O. BOX 28 LAKEVIEW, OREGON 97630 P.O. BOX 419 REDMOND, OREGON 97756
(541) 947-4407 (541) 923-4307
FAX 947-2321 FAX 923-4308

DATE: NOVEMBER 2003 DWG. FILE: 2003-64.DWG
JOB NO.: 2003-64 SHEET 1 OF 1