



T13S R13E, WM, JEFFERSON COUNTY, OR

- Well & Meter
-  POU IR
- Pipeline
- Section
- Quarter Quarter
-  Tax Lot

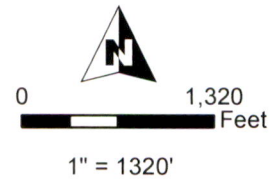

Well #2 (JEFF 50732 / L-34656) Location:
940' N, 80' W of E 1/4 Cor Sec 11

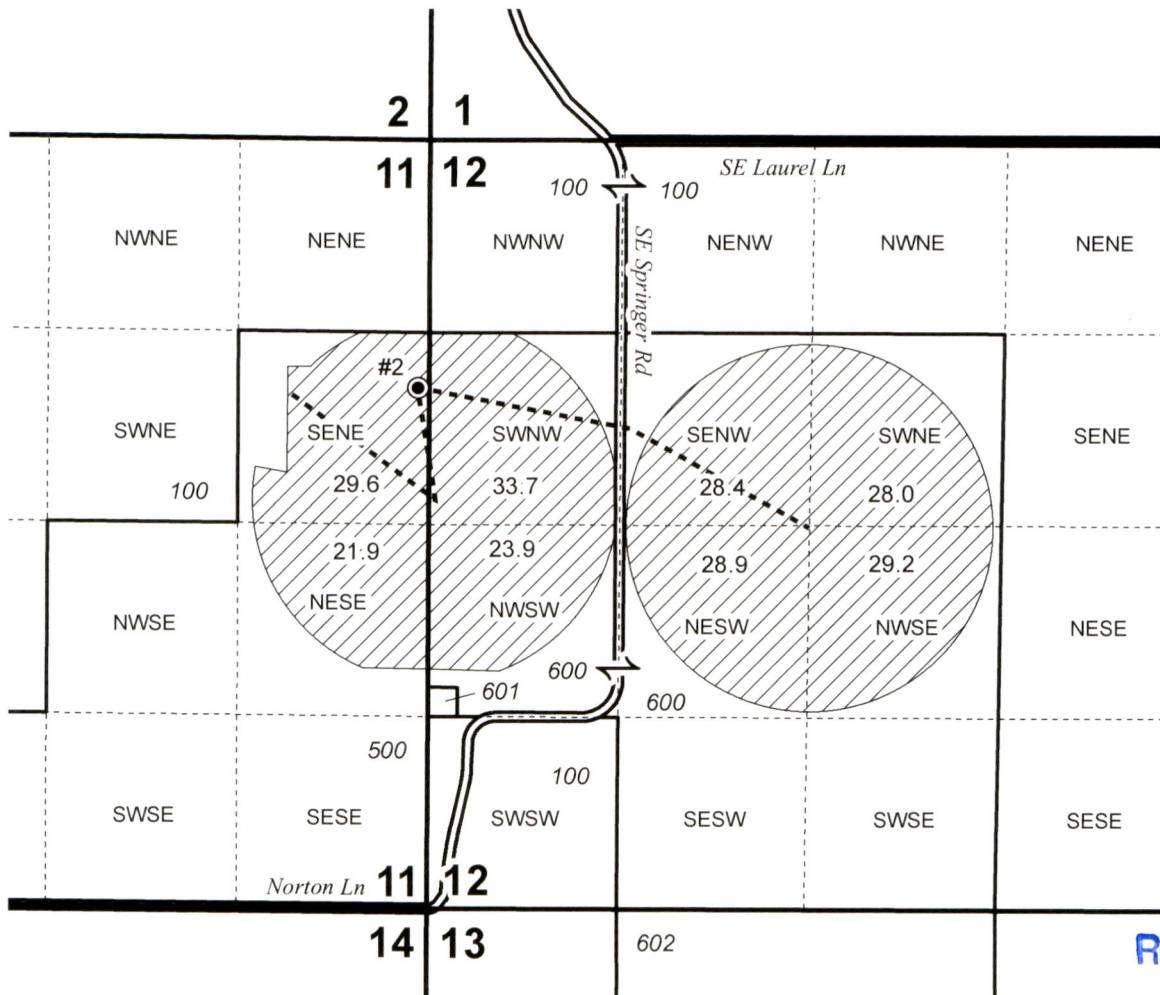

Received
FEB 18 2025

OWRD



RENEWS: 06/30/2026



CLAIM OF BENEFICIAL USE MAP LADONNA STAFFORD

Date: 1/9/2025

Ap G-15627 Permit G-15194

This map is not intended
to provide legal dimensions
or locations of property
ownership lines.

WATER RIGHT SERVICES, LLC
PO BOX 1830, BEND, OR 97709
WWW.OREGONWATER.US CCB # 197121
johnshort@usa.com 541-389-2837