



- Additional POD, Fish Screen, Meter
- Pipeline
- - - - - Creek
- Township
- Section
- Tax Lot
- - - - - Quarter Quarter
- ▨ POU IR 1/9/2022 Priority

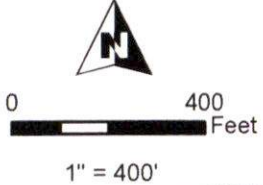

**T32S R5W &
T32S R6W, WM
DOUGLAS COUNTY, OR**

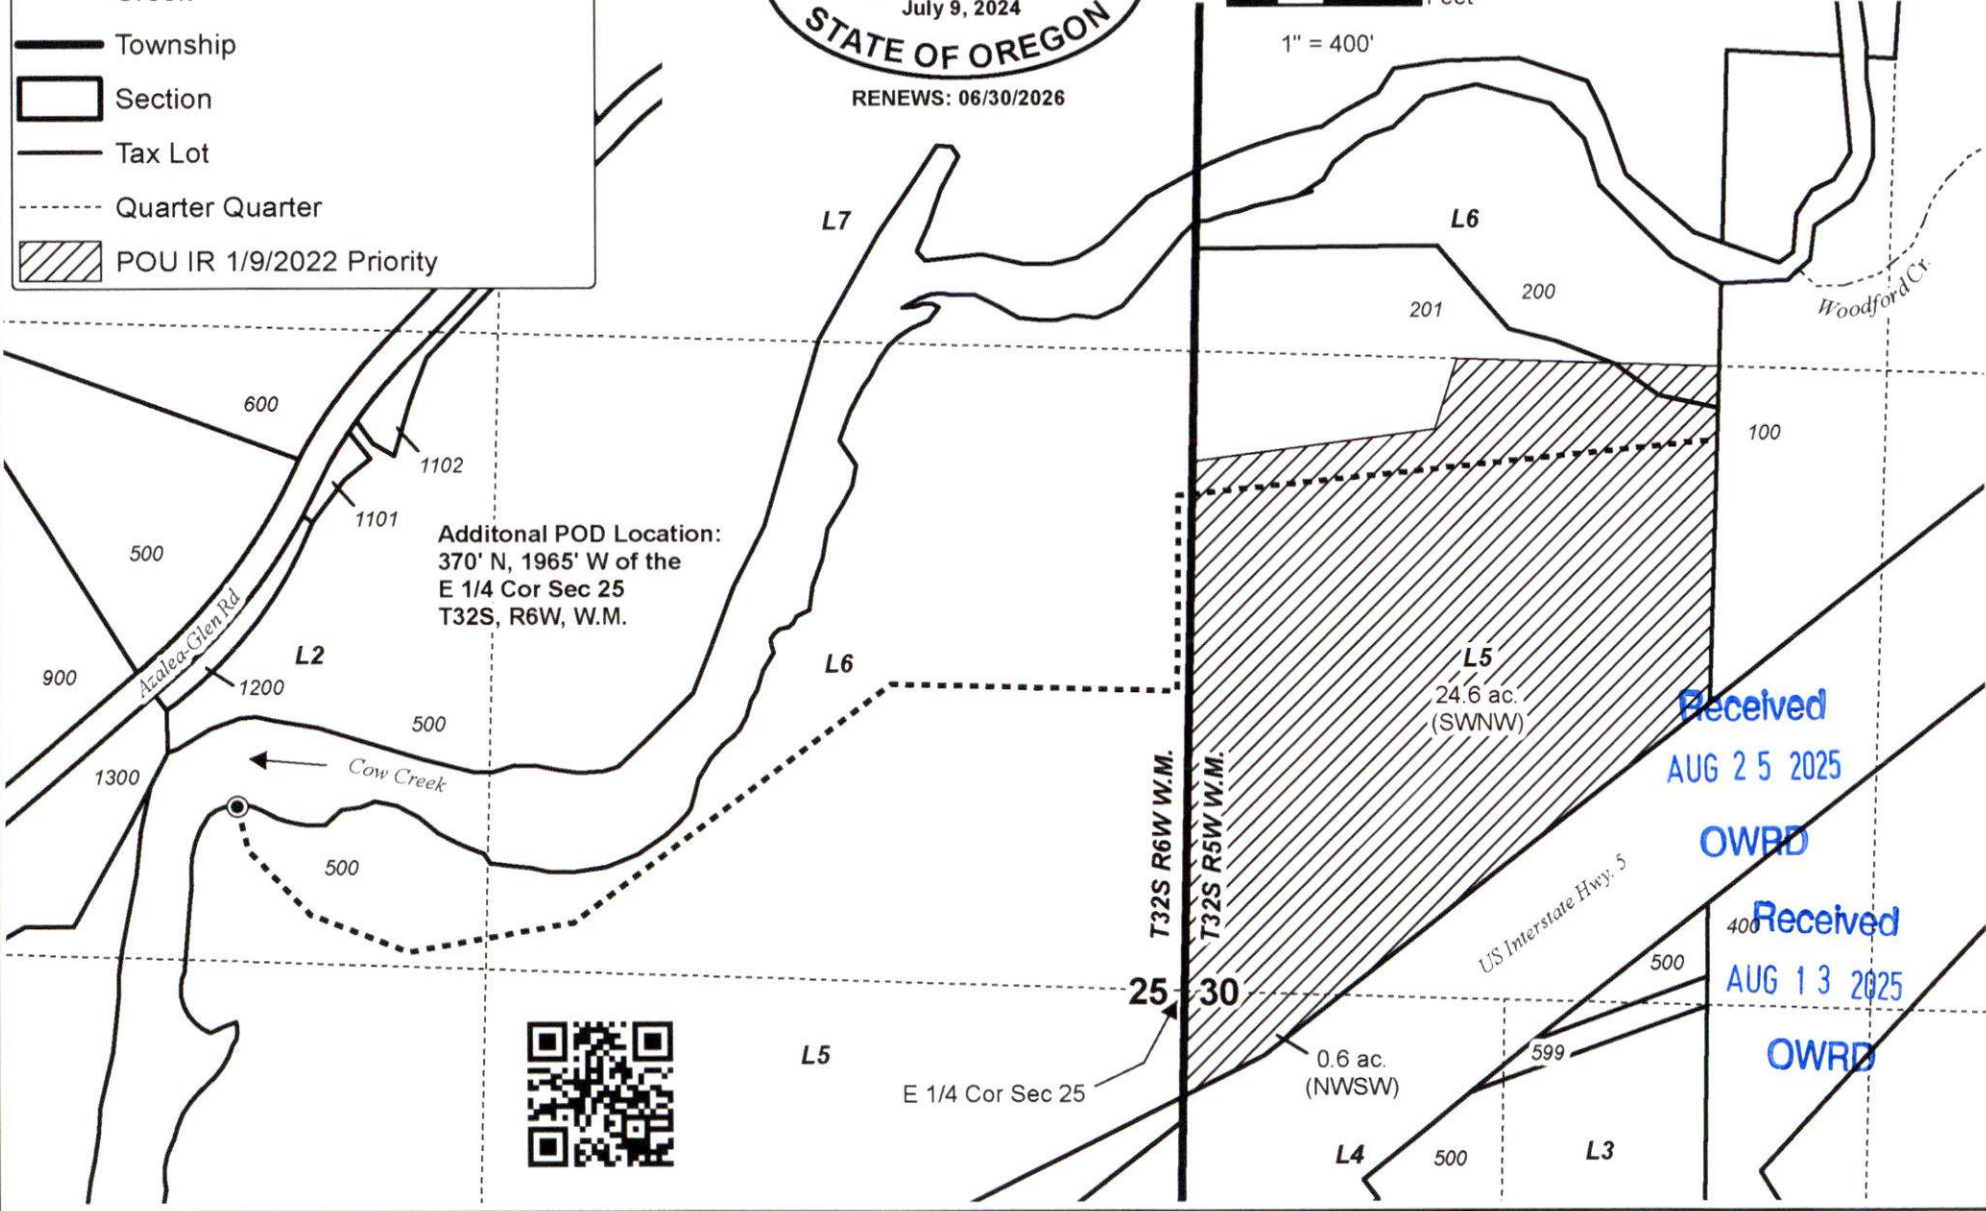

Received
AUG 25 2025

OWRD

Received
AUG 13 2025

OWRD

**CLAIM OF BENEFICIAL USE MAP
Owens**

Date: 7/29/2025 T-11627 (Additional Point of Diversion Transfer)

This map is not intended
to provide legal dimensions
or locations of property
ownership lines.

WATER RIGHT SERVICES, LLC
PO BOX 1830, BEND, OR 97709
WWW.OREGONWATER.US CCB # 197121
brycewrs@gmail.com 541-389-2837