

Received
AUG 25 2025

T.4S. R.1W. Section 26, W.M.

OWRD


Well A (MARI 774) is located 20.5 chains south and 6.75 chains east from the NE corner, DLC 63.

Well F (MARI 1021) is located 184 feet south and 1,550 feet east from the NW corner, DLC 53.

 Area (66.7 Acres) irrigated under T-13384, formerly Certificate 29405, priority date: November 13, 1958.

----- Tax lot boundary Water main line, buried

----- Donation Land Claim boundary - - - - - Water main line, portable

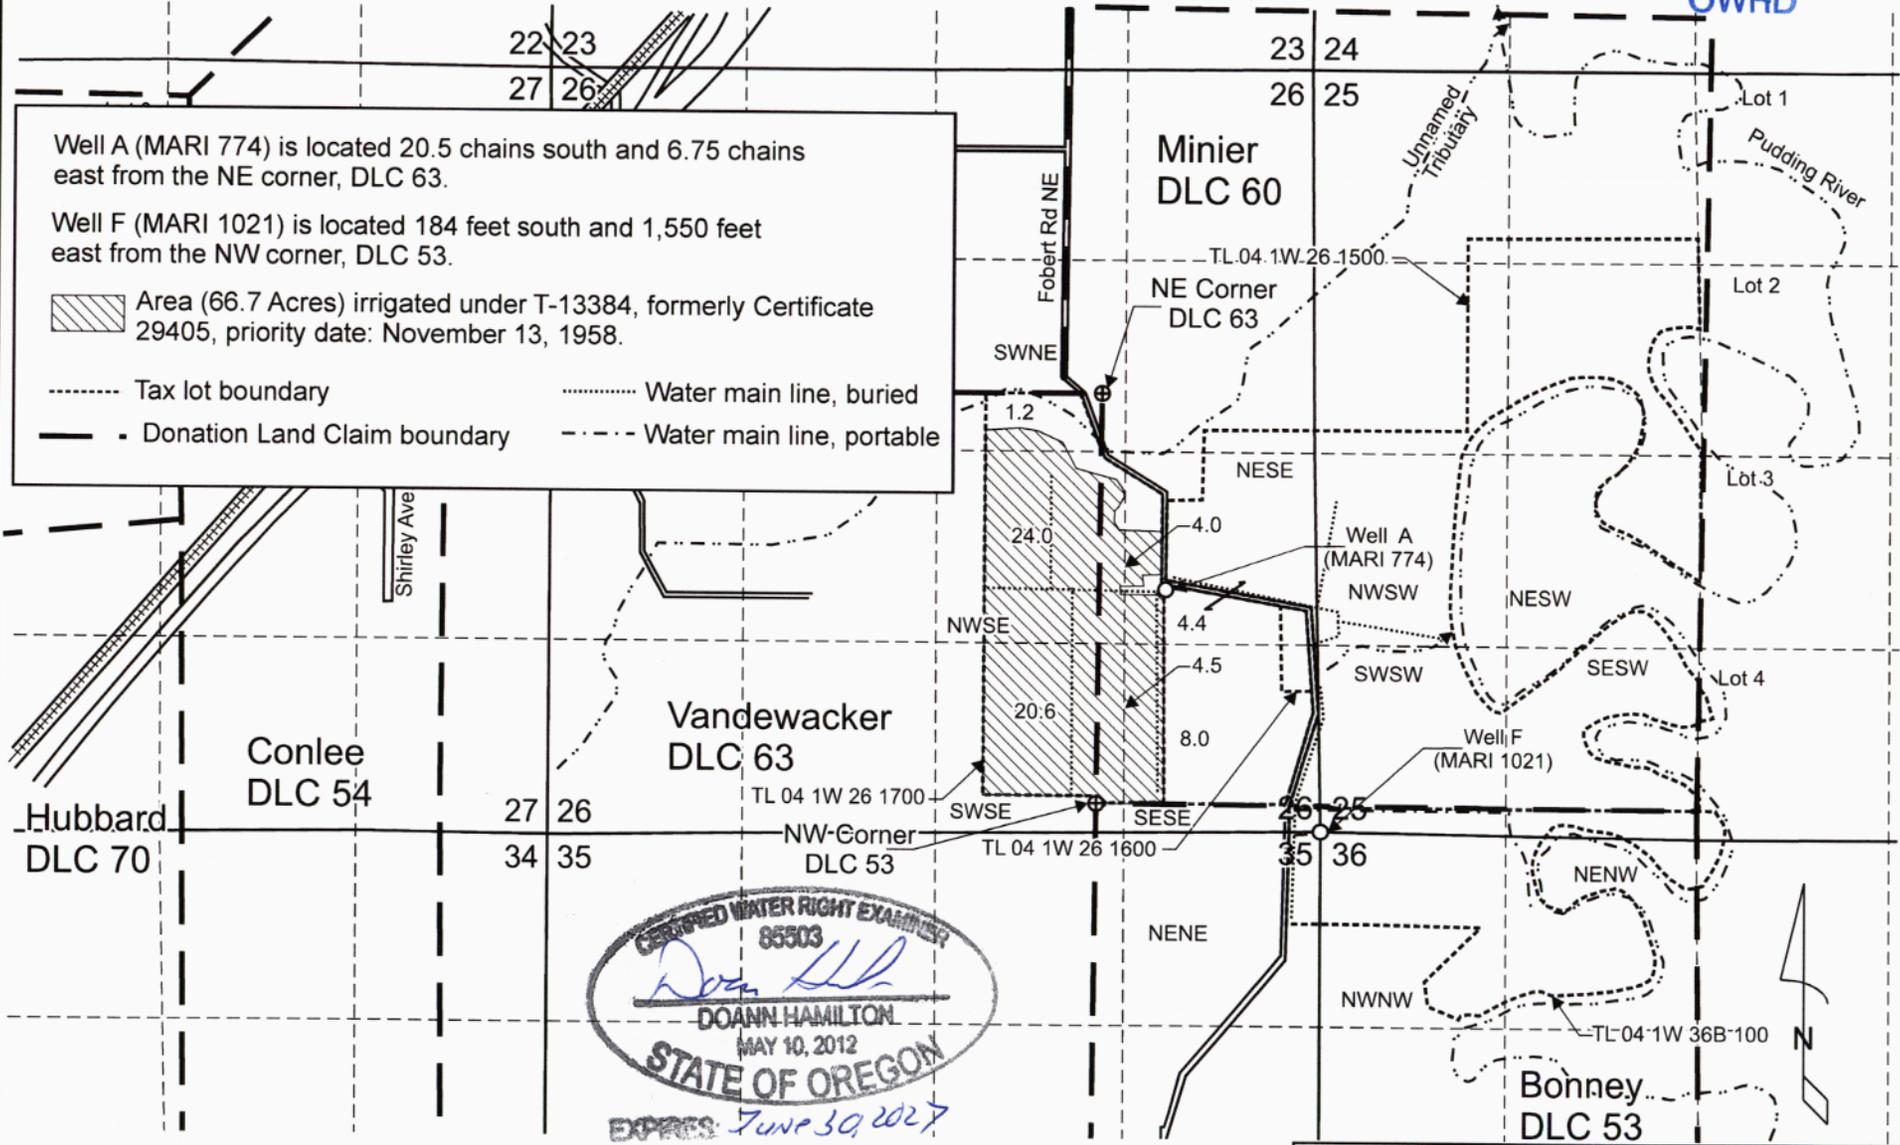

CERTIFIED WATER RIGHT EXAMINER
85503
Doann Hamilton
DOANN HAMILTON
MAY 10, 2012
STATE OF OREGON
EXPIRES: *JUNE 30, 2027*

Scale: 1" = 1,320'



0 1,320
Feet

This map was prepared for the purpose of identifying the location of a water right only and is not intended to provide legal dimensions or location of property ownership lines.

Pacific Hydro-Geology Inc.

Claim of Beneficial Use Map
T-13384 formerly, Certificate 29405

Paul and Susan Fobert
T.4S. R.1W. Section 26, W.M.

08/2025

FobartT-13384Cert29405COBUMap.cdr