


T.4S. R.1W. Sec. 25, 26, 35 & 36, W.M.

OWRD

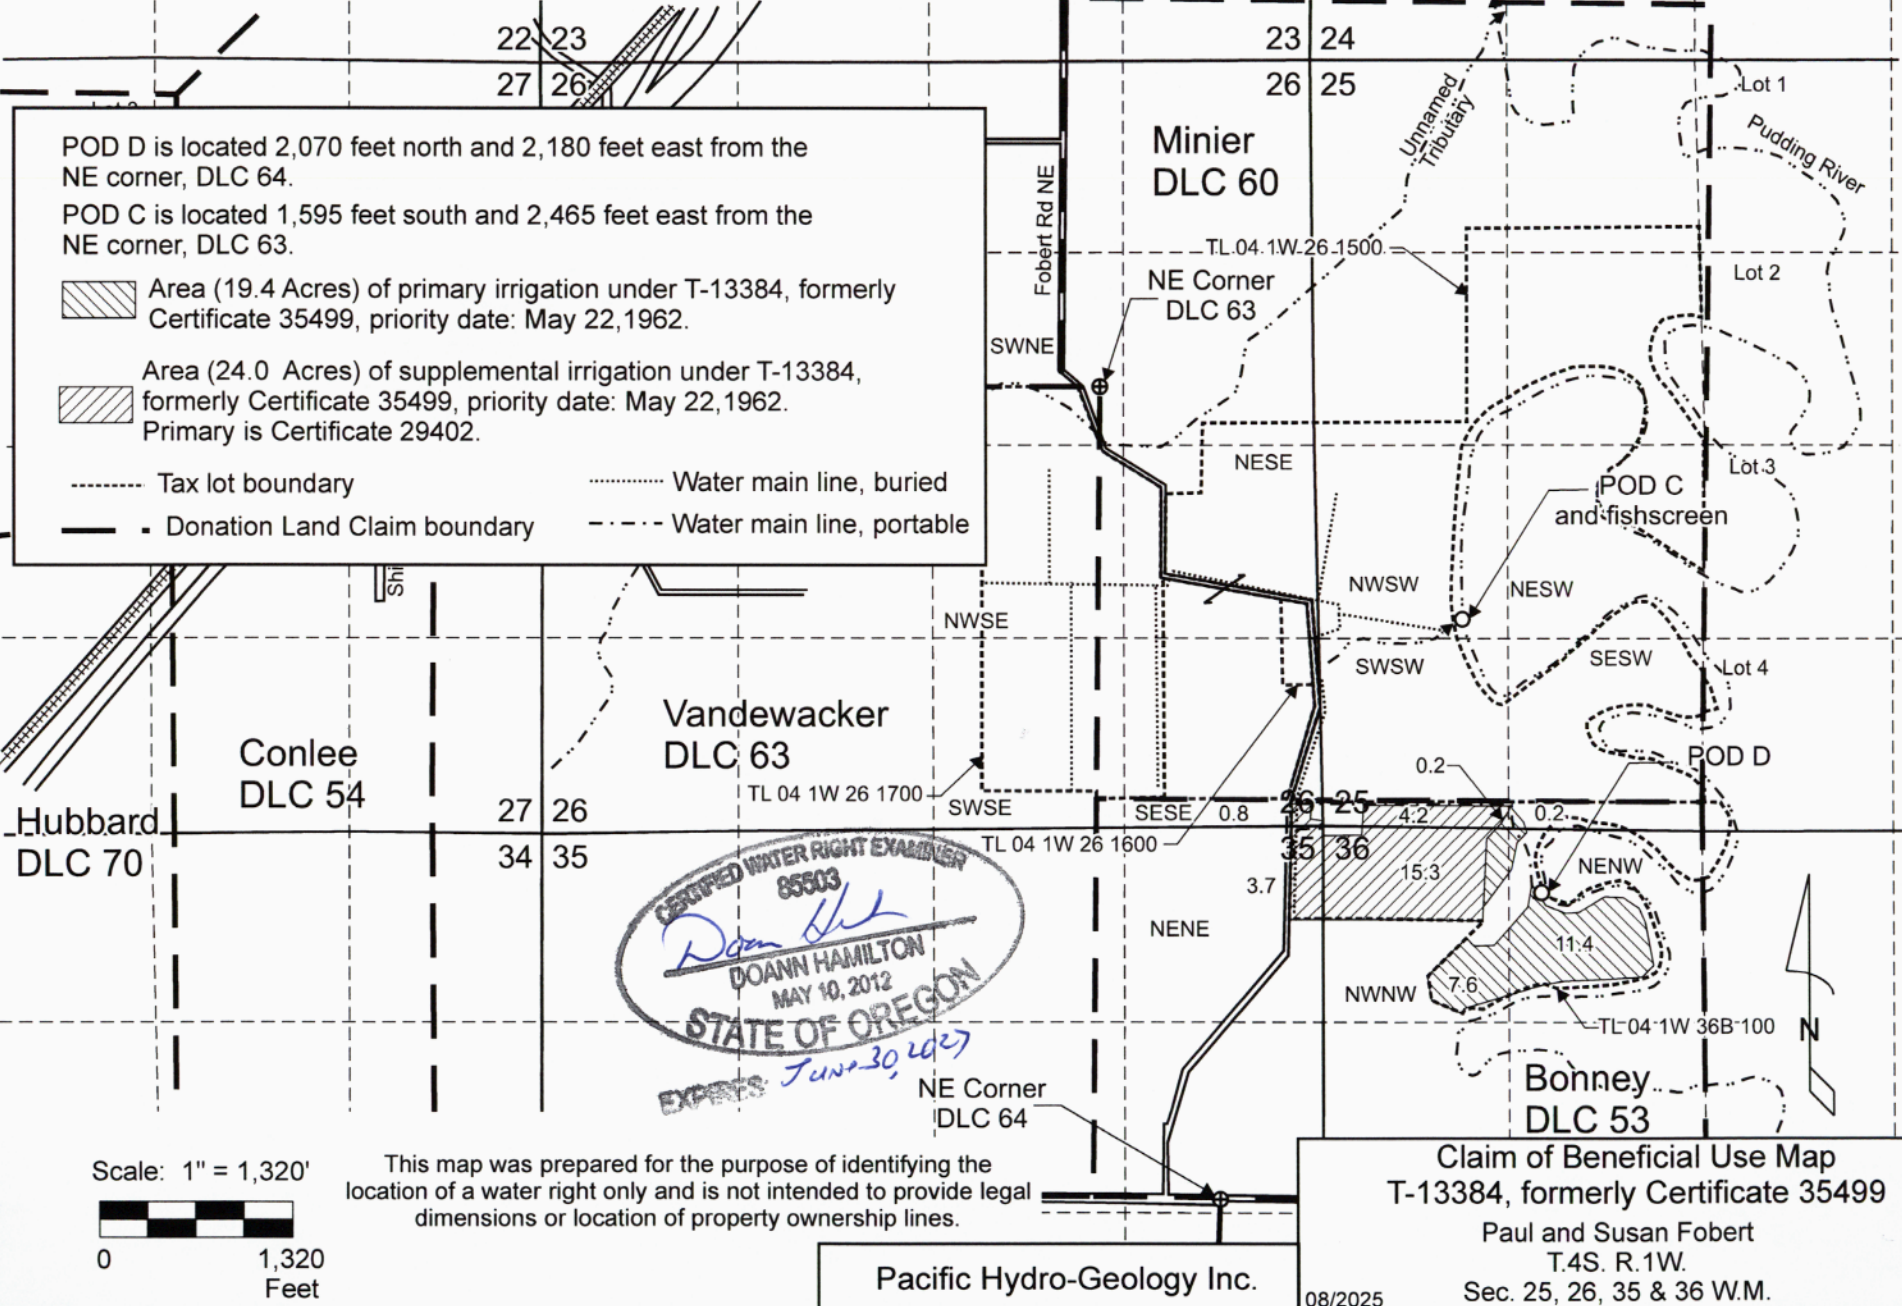

POD D is located 2,070 feet north and 2,180 feet east from the NE corner, DLC 64.
 POD C is located 1,595 feet south and 2,465 feet east from the NE corner, DLC 63.

Area (19.4 Acres) of primary irrigation under T-13384, formerly Certificate 35499, priority date: May 22, 1962.

Area (24.0 Acres) of supplemental irrigation under T-13384, formerly Certificate 35499, priority date: May 22, 1962. Primary is Certificate 29402.

----- Tax lot boundary
 - - - - - Donation Land Claim boundary
 Water main line, buried
 - · - · - Water main line, portable


CERTIFIED WATER RIGHT EXAMINER
 85503
Doann Hamilton
 DOANN HAMILTON
 MAY 10, 2012
 STATE OF OREGON
 EXPIRES *June 30, 2027*

Claim of Beneficial Use Map
T-13384, formerly Certificate 35499
 Paul and Susan Fobert
 T.4S. R.1W.
 Sec. 25, 26, 35 & 36 W.M.

Pacific Hydro-Geology Inc.

08/2025

FobartT-13384Cerr35499COBUMap.cdr

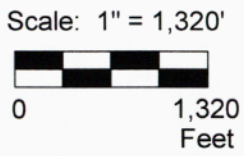

This map was prepared for the purpose of identifying the location of a water right only and is not intended to provide legal dimensions or location of property ownership lines.