

T.4S. R.1W. Section 19, W.M.



RECEIVED
 JAN 26 2021
 OWRD
 OWRD

Case
 DLC 47

Hall
 DLC 47


Whitney
 DLC 48

TL 04 1W 19C 400

Olmstead Rd NE

Ryan Creek

19

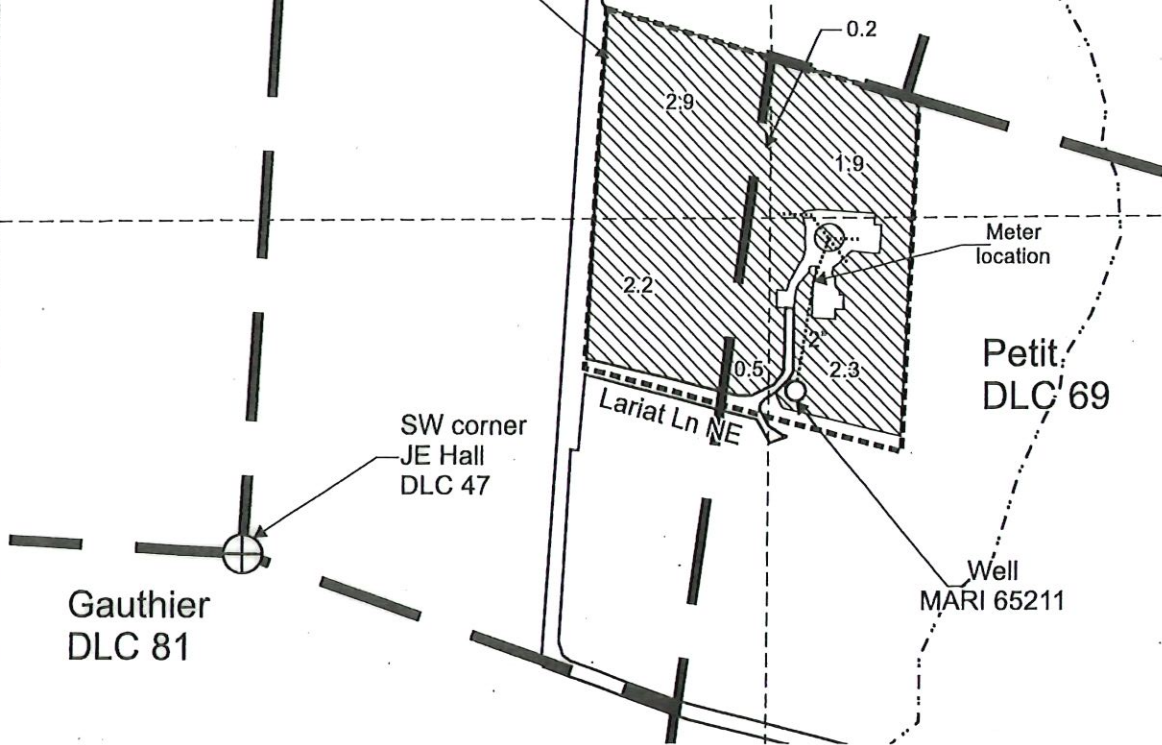

Well (MARI 65211) is located 340 feet north and 1,145 feet east from the SW corner, JE Hall DLC 47.


Area (10.0 Acres) irrigated under Application G-17716, Permit G-17155.

Tax lot boundary

Donation Land Claim boundary

Water main line

Scale: 1" = 400'

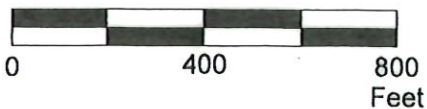

This map was prepared for the purpose of identifying the location of a water right only and is not intended to provide legal dimensions or location of property ownership lines.



Claim of Beneficial Use Map
 Application G-17716, Permit G-17155

Brian and Bridget Dupont
 T.4S. R.1W. Section 19, W.M.

Pacific Hydro-Geology Inc.

01/2021

Dupont.BAG-17716COBUMap.cdr