


FINAL PROOF SURVEY MAP

IN THE NAME OF RICHARD H. OR LESLIE J. CLARKE

APPLICATION G-13233

PERMIT G-12268

SECTION 12, TOWNSHIP 29 SOUTH, RANGE 15 WEST, W.M.

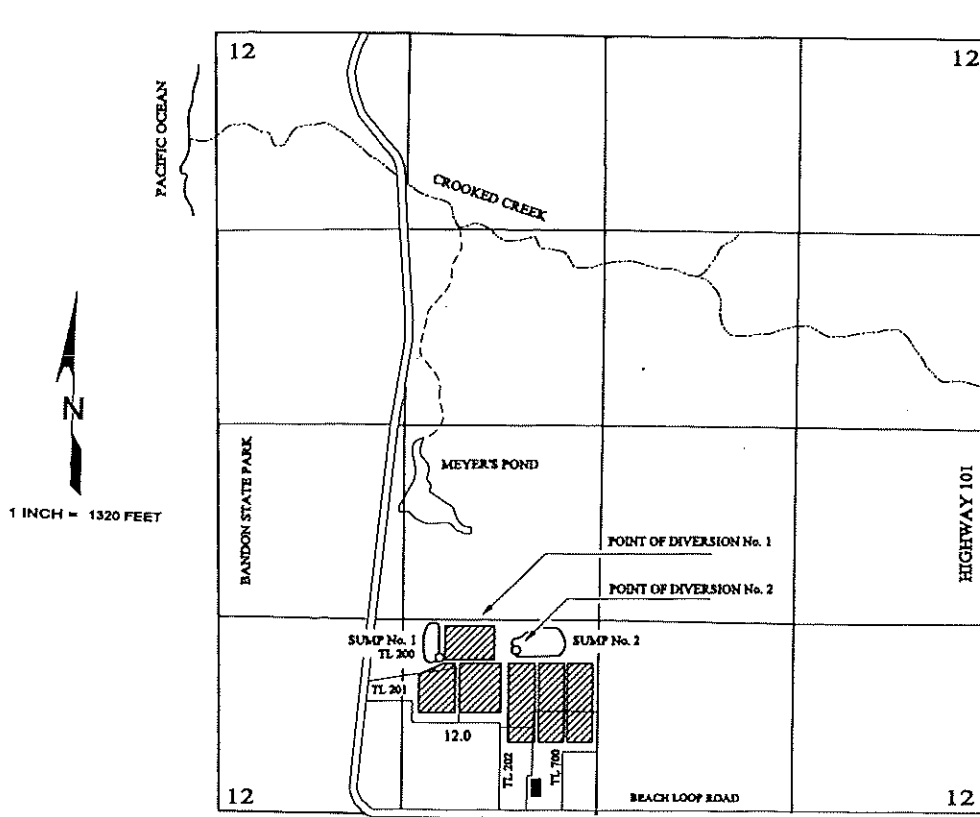


POINT OF DIVERSION No. 1 IS LOCATED 1,050 FEET NORTH AND 1,070 FEET WEST AND POINT OF DIVERSION No. 2 IS LOCATED 1,120 FEET NORTH AND 570 FEET WEST; BOTH FROM THE SOUTH QUARTER CORNER OF SECTION 12; BOTH BEING WITHIN THE SE $\frac{1}{4}$ SW $\frac{1}{4}$ OF SECTION 12, TOWNSHIP 29 SOUTH, RANGE 15 WEST, W.M.; COOS COUNTY.

RECEIVED

AUG 16 2000

WATER RESOURCES DEPT.
SALEM, OREGON

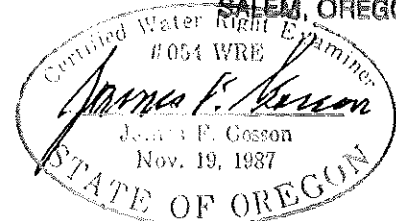

THE PURPOSE OF THIS MAP IS TO IDENTIFY THE LOCATION OF THE WATER RIGHT. IT IS NOT INTENDED TO PROVIDE INFORMATION RELATIVE TO THE LOCATION OF PROPERTY OWNERSHIP BOUNDARY LINES.