


TOWNSHIP 19 SOUTH, RANGE 14 EAST, W.M.

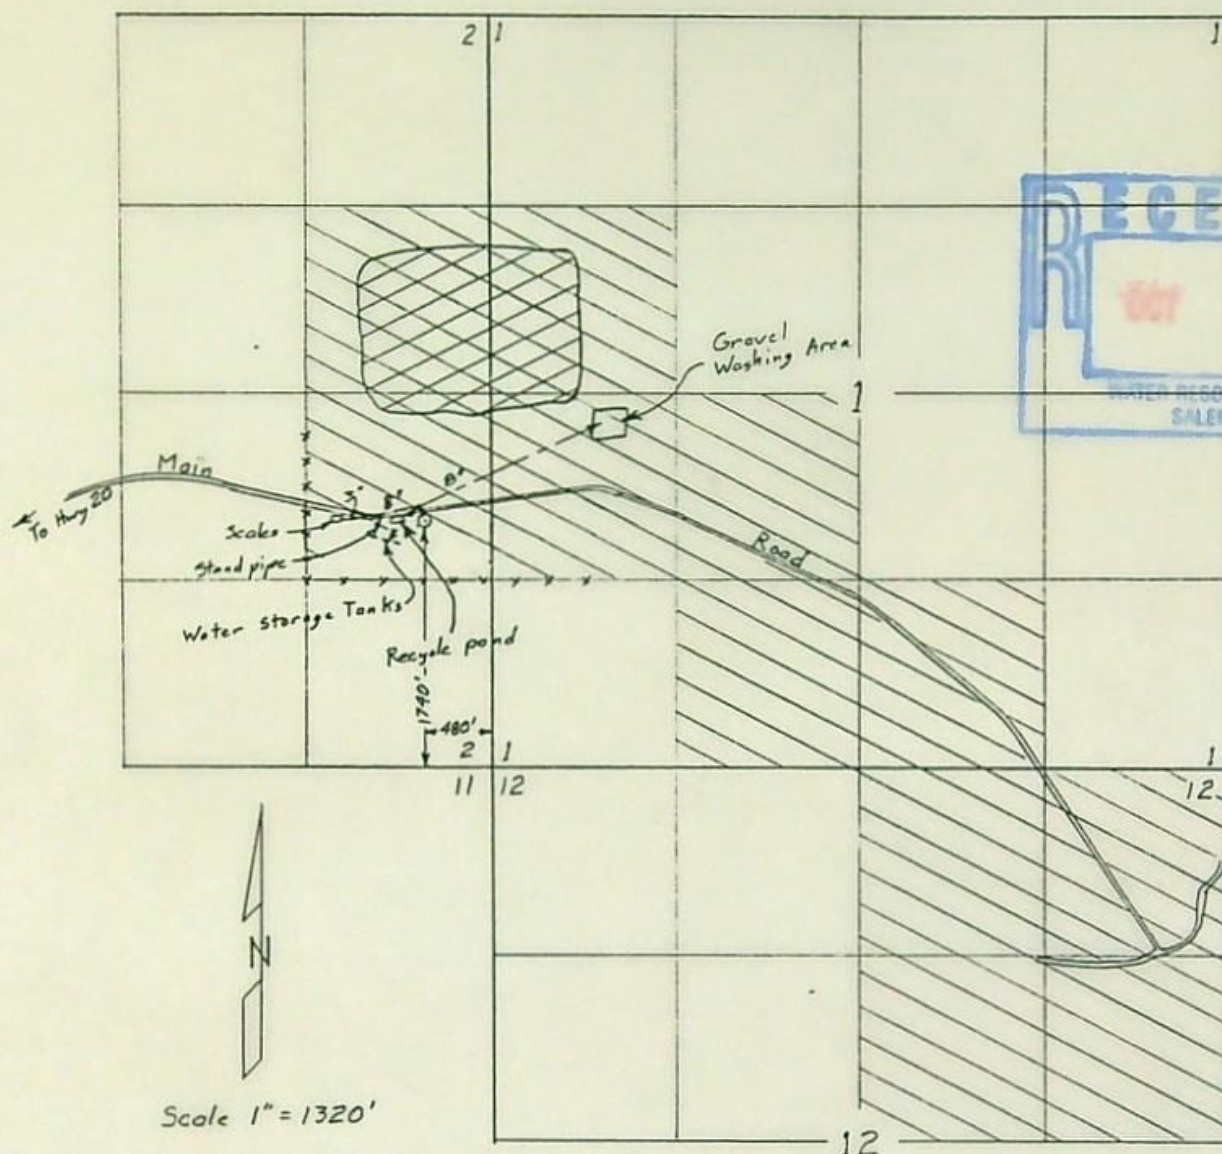

- ⊗ Mined Area
- ⊗ Area to be Mined

Surveyed September 21, 2000

Claim of Beneficial Use Map
for
HOWARD M. DAY
(Moon Mine)



App G-13686
Per G-12860

This map is for the purpose of
locating a water right only
and has no intent to provide
legal dimensions or the location
of property lines.

ESTES SURVEYS

PO Box 17519 60382 Arnold Rd
Salem, OR 97305-7519 Bend, OR 97702
(503) 585-7593 (541) 382-7391