
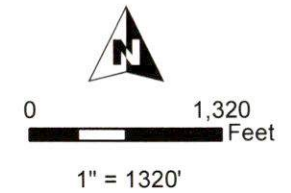


**T4S R23E, WM,
GILLIAM COUNTY, OR**

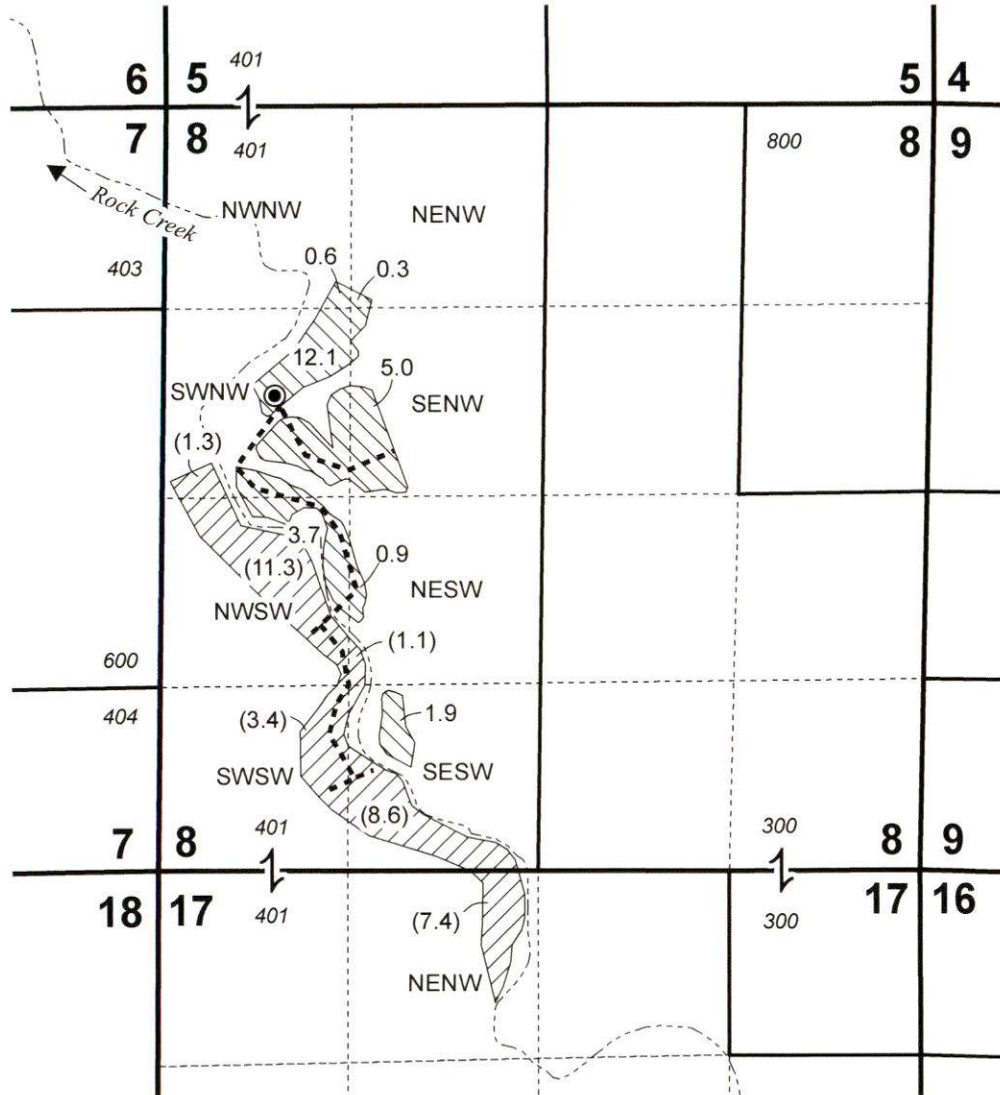

- Well & Meter
- Creek
- Pipeline
- Primary Irrigation Apr 1- Oct 31
- Primary Irrigation Oct 1 - Oct 31; Supp. Irrigation Apr 1 - Sept 30
- Section
- Quarter Quarter
- Tax Lot

Well (GILL 50778/L-135301) Location:
1990' S, 740' E of NW Cor Sec 8

Received
NOV 19 2025
OWRD



**CLAIM OF BENEFICIAL USE MAP
Campbell Ranch**

Date: 11/3/2025 Ap G-17938 Permit G-17565

This map is not intended
to provide legal dimensions
or locations of property
ownership lines.

WATER RIGHT SERVICES, LLC
PO BOX 1830, BEND, OR 97709
WWW.OREGONWATER.US CCB # 197121
brycewrs@gmail.com 541-389-2837