

North Scale = 20 CHS TO 1 INC

TP-3 SR3 W WM

2571 2490 2490 2490

Application No. 11736
Permit No. 8108

Application No. 11737
Permit No. R 508

DUNDEE ORCHARD HOMES MO1
JACOB SHUCK
DLC No 57

CHEVALEY ORCHARD HOMES ANNEX

CHARLES HADLEY
DLC No 56

CHEVALEY ORCHARD HOMES

Daniel Hess
Not No 28
35

ANSON G HENRY
DLC No 2060

EDWARD R GEARY
DLC No 65

SEWARD FULGUARDS
DLC No 70

EAST

WEST

SOUTH

ARVCHILL
DLC No 55

25

26

27

3

5

6

3

7

5

9

9

9

10

7

3

3

3

4

4

4

7

7

Sec. 36

Tp 35

R 3 W

This sketch prepared in State Engineer's office from original sketch.

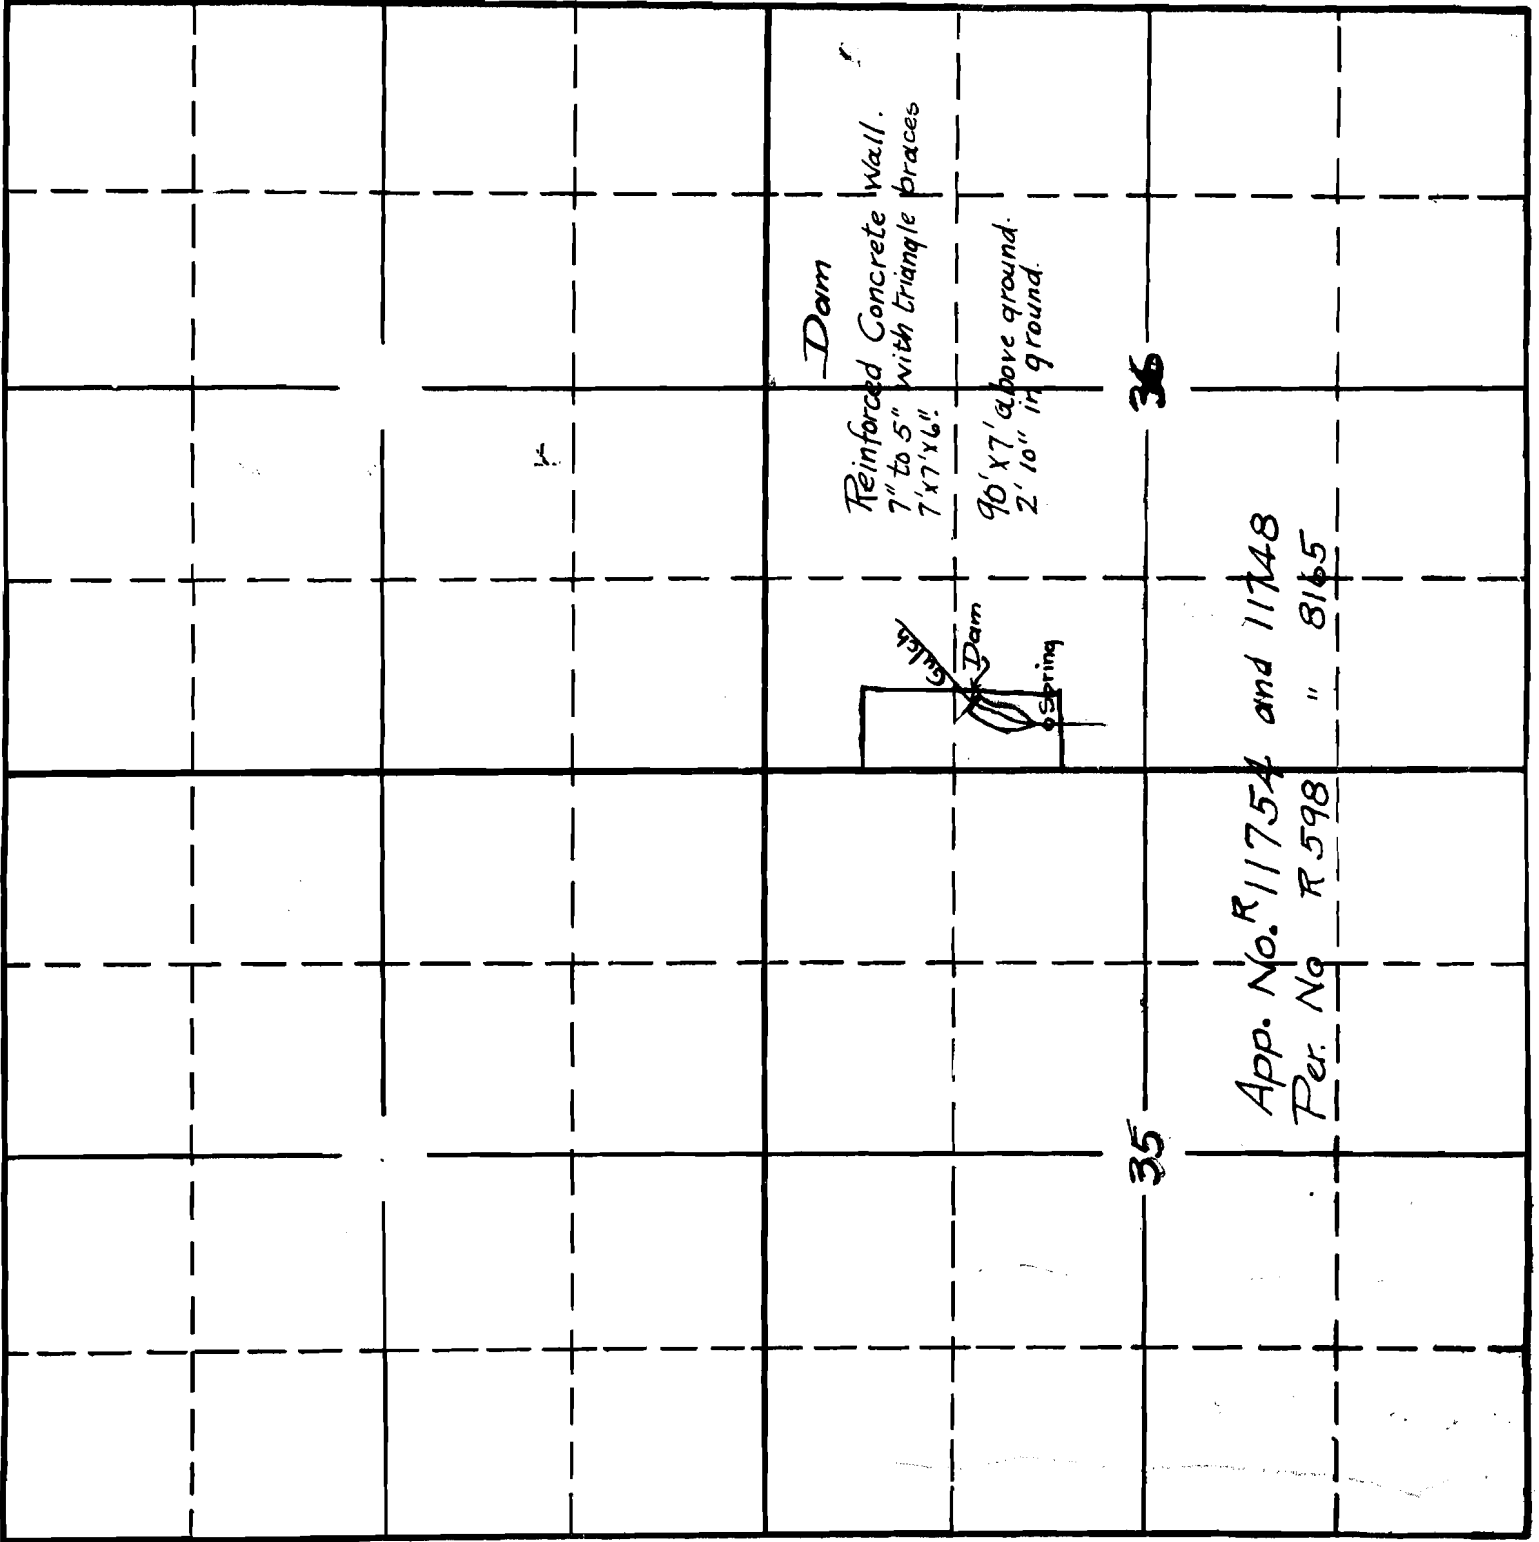

35

36

App. No. R 11754 and 11748
Per. No. R 598 " 8165