


SUPERSEDING

MAP TO ACCOMPANY APPLICATION TO CHANGE
POINT OF APPROPRIATION AND PLACE OF USE
PERTAINING TO CERTIFICATE 19830 (JONES 1947)
FOR MARTIN RANCHES, LP

TAX LOTS 100, 200, 200, 600, & 800
IN SECTIONS 8, 9, 16, AND 17,
TOWNSHIP 36 SOUTH, RANGE 11 EAST, W.M.
KLAMATH COUNTY, OREGON

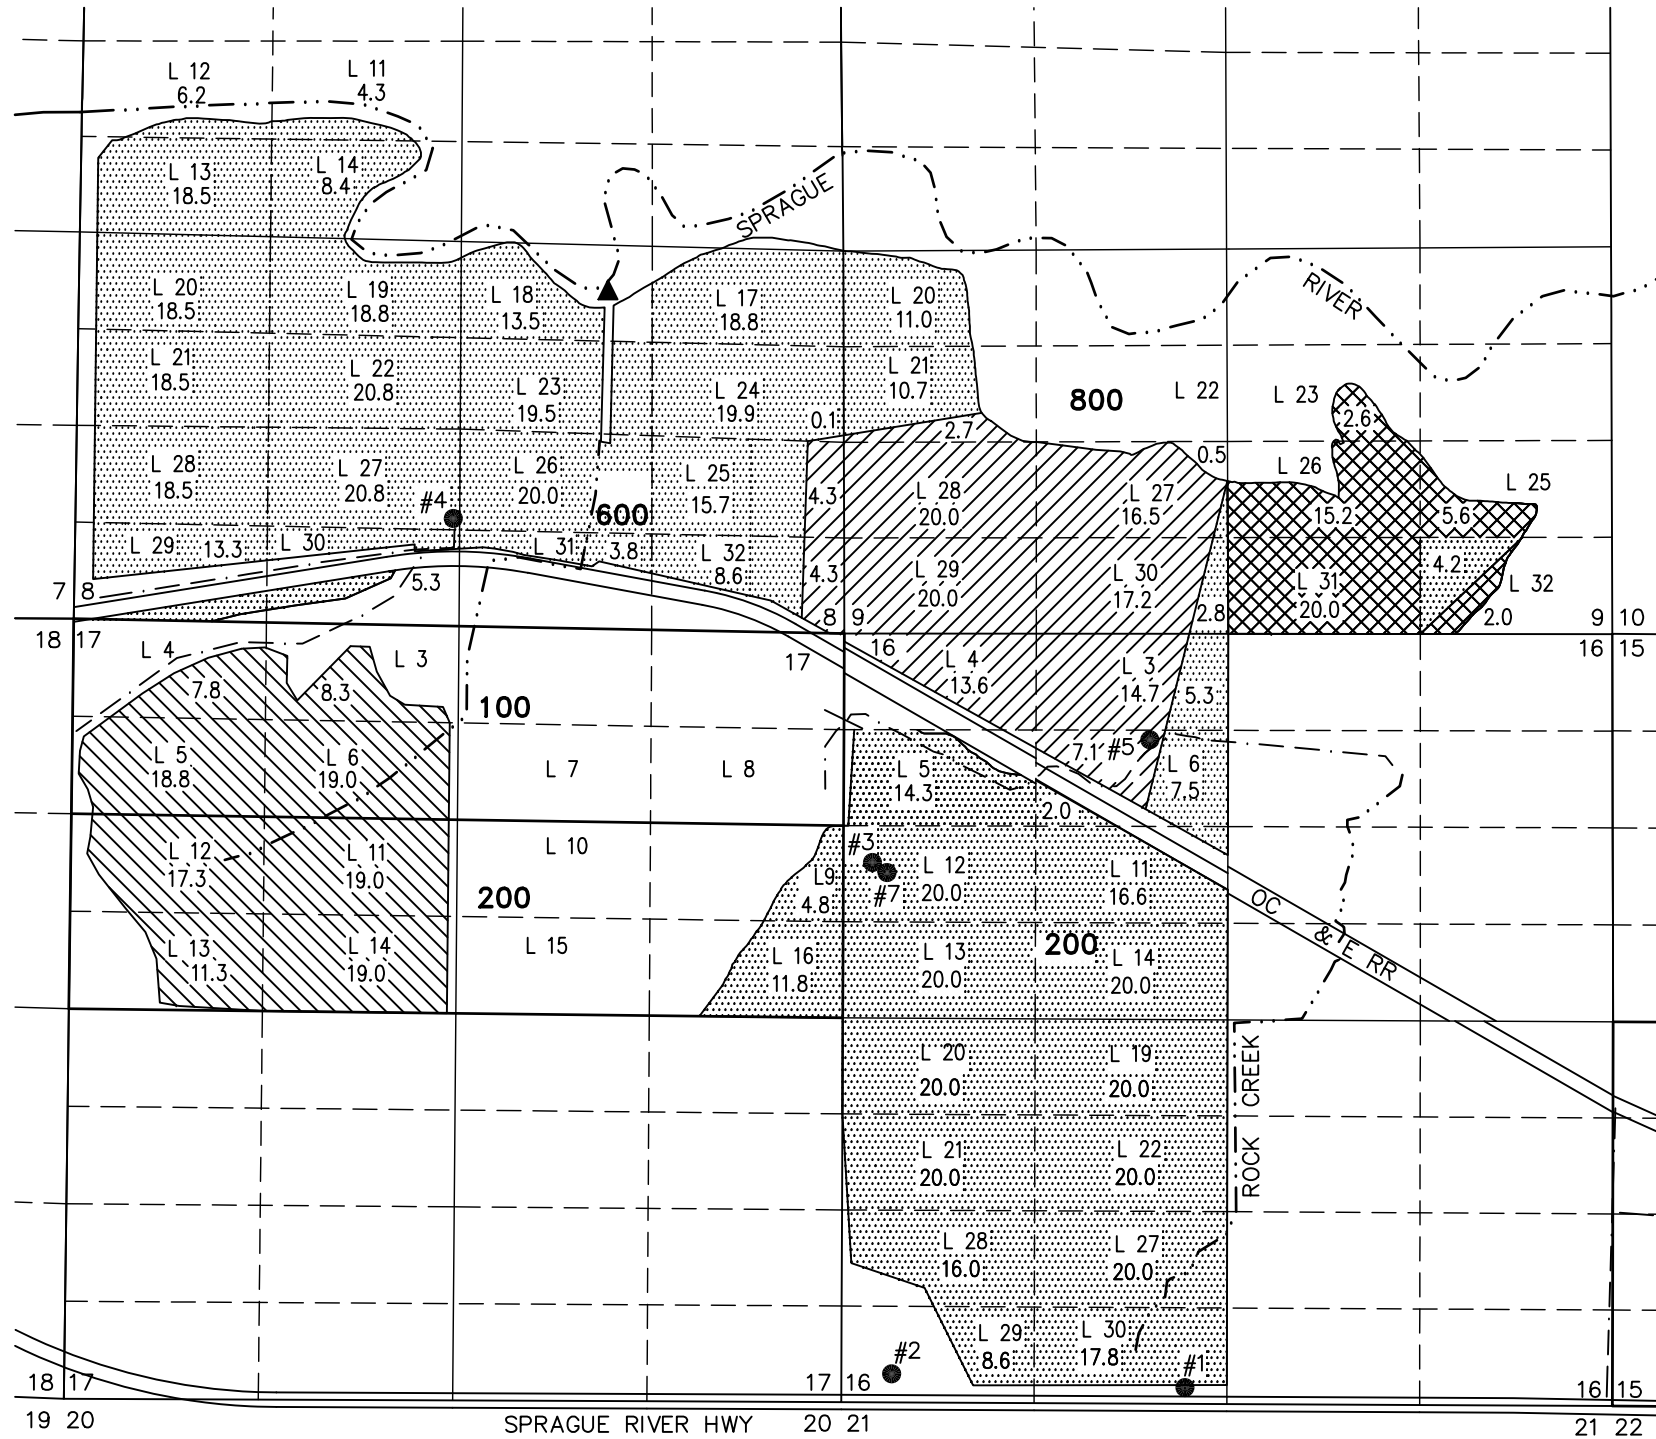


- WELL#1 (KLAM 1974) AUTHORIZED BY C19830, LOCATED 111 FEET NORTH AND 269.8 FEET WEST FROM THE S 1/4 CORNER OF SECTION 16.
- WELL#2 (KLAM 1973) AUTHORIZED BY C19830, LOCATED 224.5 FEET NORTH AND 348.5 FEET EAST FROM THE SW CORNER OF SECTION 16.
- WELL#3 (KLAM 1970) AUTHORIZED BY C19830, LOCATED 1184.8 FEET NORTH AND 237 FEET EAST FROM THE W 1/4 CORNER OF SECTION 16.
- WELL#4 (KLAM 1945) AUTHORIZED BY C19830, LOCATED 779.1 FEET NORTH AND 61.5 FEET WEST FROM THE S 1/4 CORNER OF SECTION 8.
- WELL#5 (KLAM 1972) AUTHORIZED BY C19830, LOCATED 724.1 FEET SOUTH AND 2076.9 FEET EAST FROM THE NW CORNER OF SECTION 16.
- WELL#7 (KLAM 1978) AUTHORIZED BY C27806, LOCATED 1000 FEET NORTH AND 300 FEET EAST FROM THE W1/4 CORNER OF SECTION 16.

CONVEYANCE CANAL

- ▲ POD AUTHORIZED BY C20358, LOCATED WITHIN LOT 18, SECTION 8, AS SHOWN.

- 120.5 ACRES IR FROM POAS 1-5 TRANSFERRED OFF, AS SHOWN.
- 120.5 ACRES IR FROM POAS 1-5 TRANSFERRED ON, AS SHOWN.
- 470.1 ACRES IR FROM POAS 1-5 REMAIN, AS SHOWN.
- 45.4 ACRES IS FROM POAS 1-5 REMAIN, AS SHOWN.

THIS MAP IS FOR THE PURPOSE OF LOCATING A WATER
RIGHT ONLY AND HAS NO INTENT TO PROVIDE LEGAL
DIMENSIONS OR THE LOCATION OF PROPERTY LINES.

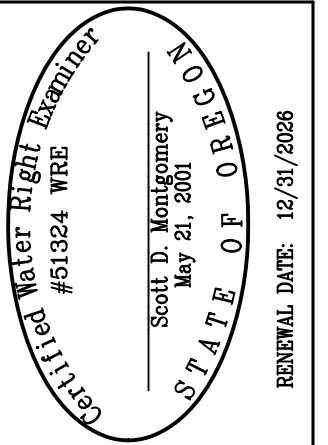

ALL POINTS ENGINEERING
& SURVEYING, INC.

P.O. BOX 767
TERREBONNE, OREGON 97760
(541) 548-5833 PH
Scott@APEandS.com
www.APEandS.com

PROJECT No. 21-137

PREPARED AT THE REQUEST OF:

MARTIN RANCHES, LP
2021 STATE HWY 88
IONE, CA 95640

T.36S.R.11E.W.M.

Application No. U-240 Permit No. U-216

CHARLES E. DREW & SON

Surveyed MAY 22 1951, by H.L. COFFMAN

NO. S 1, 3, 4 & 5 ARTESIAN WELLS

