


11 E.W.M


Permit U-534

U-2:
21236

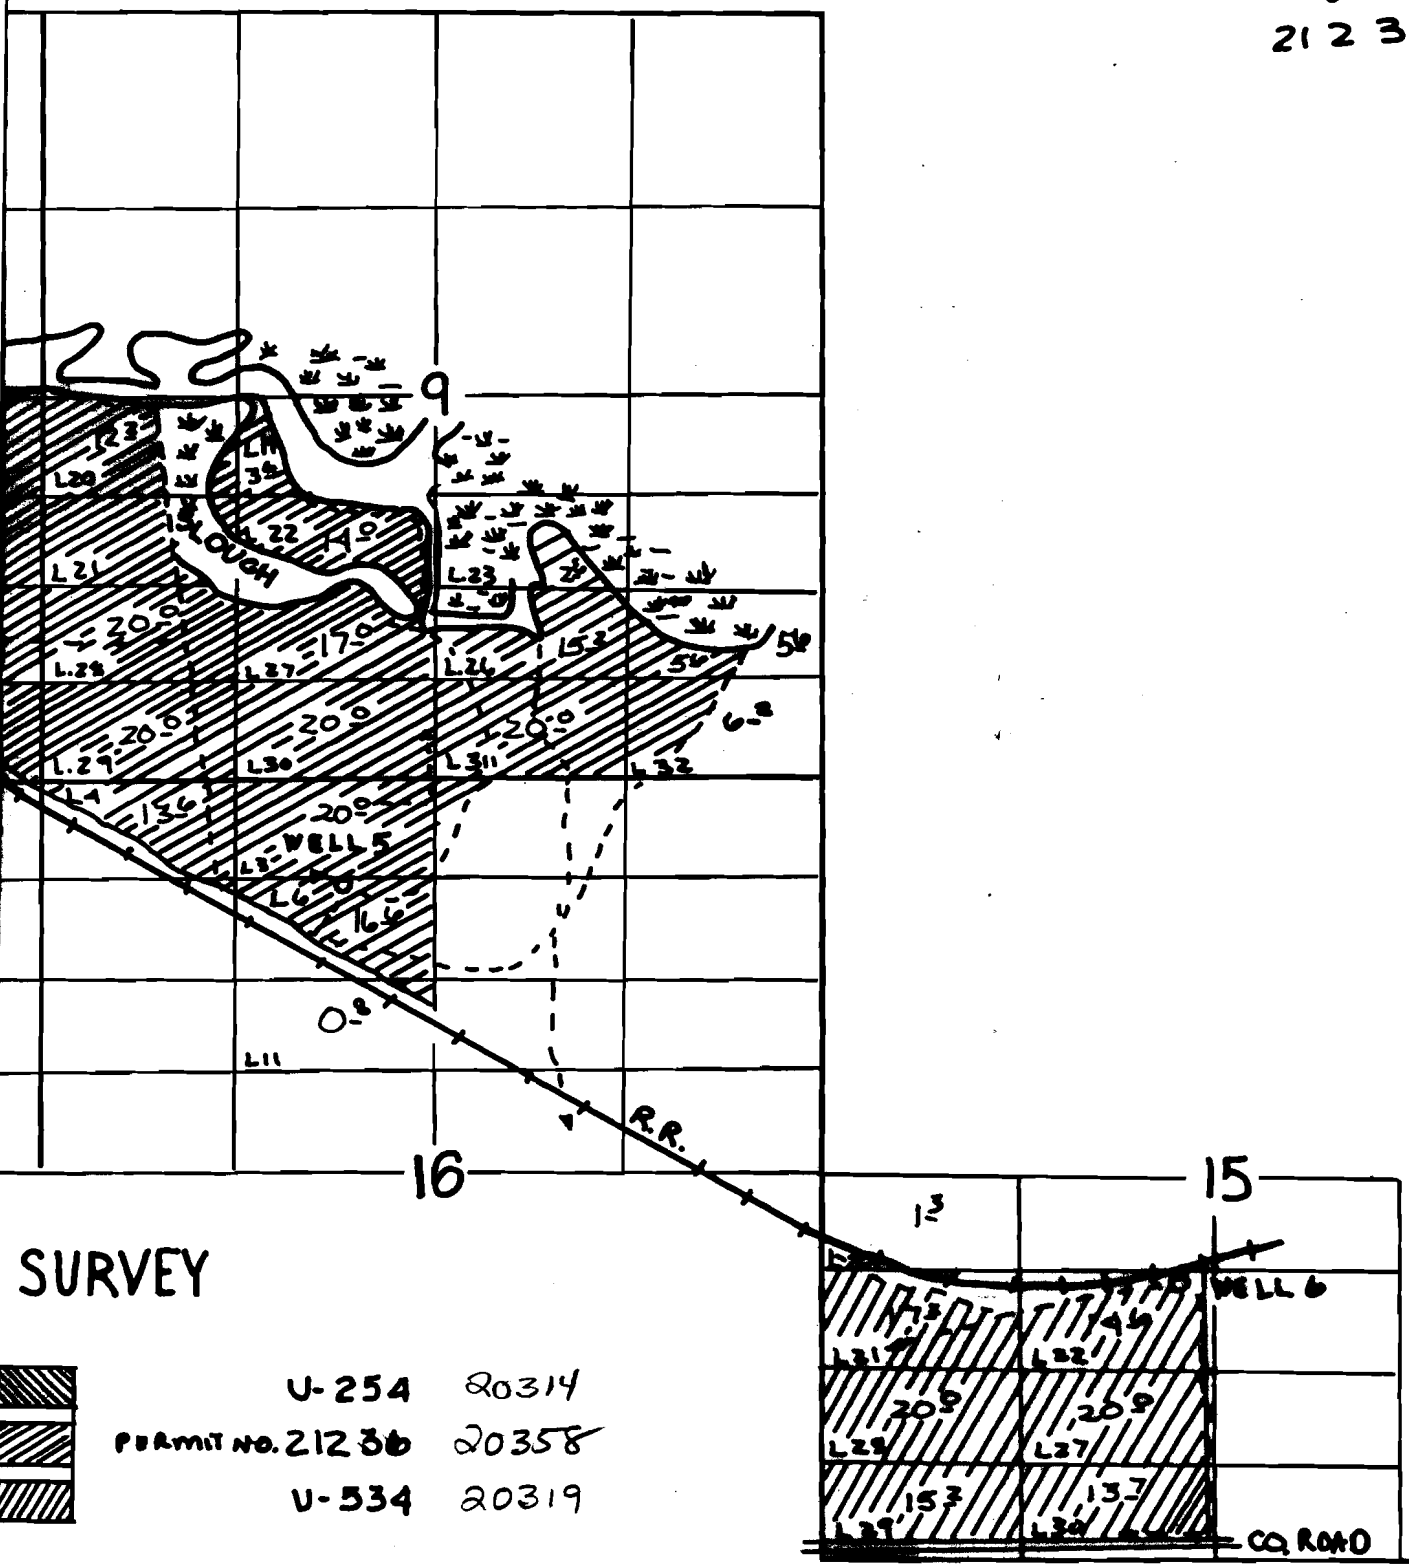

Virginia Goularte

T.36 S. R

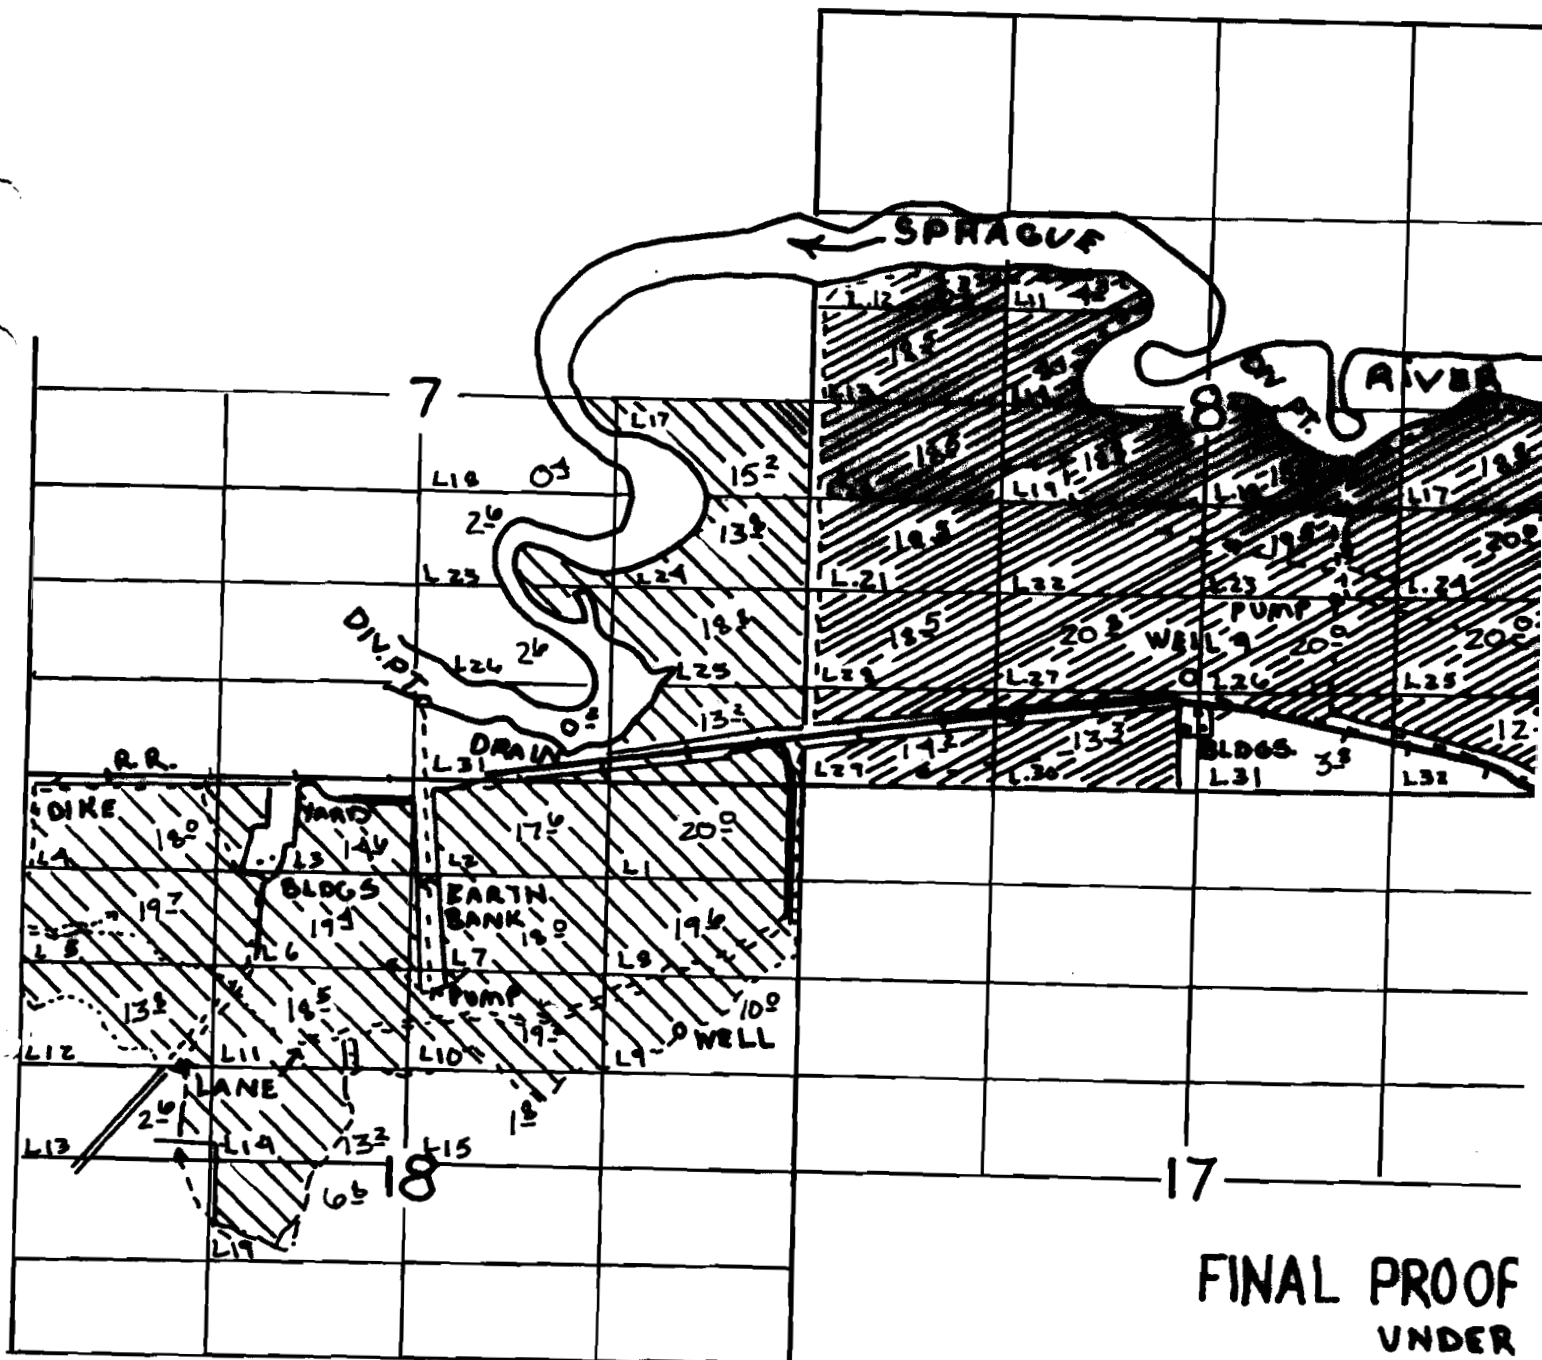

FINAL PROOF
UNDER

U-244

APPLICATION NO. 25643

U-585

IN NAME OF

D.M. Hess

Frank &