

MAP TO ACCOMPANY APPLICATION TO CHANGE POINT OF APPROPRIATION AND PLACE OF USE PERTAINING TO CERTIFICATE 41860 FOR MARTIN RANCHES, LP

TAX LOTS 2700 & 2800
IN TOWNSHIP 36 SOUTH, RANGE 11 EAST, W.M.
KLAMATH COUNTY, OREGON

RECEIVED


NOV 02 2022

RECEIVED

NOV 28 2022


OWRD

OWRD

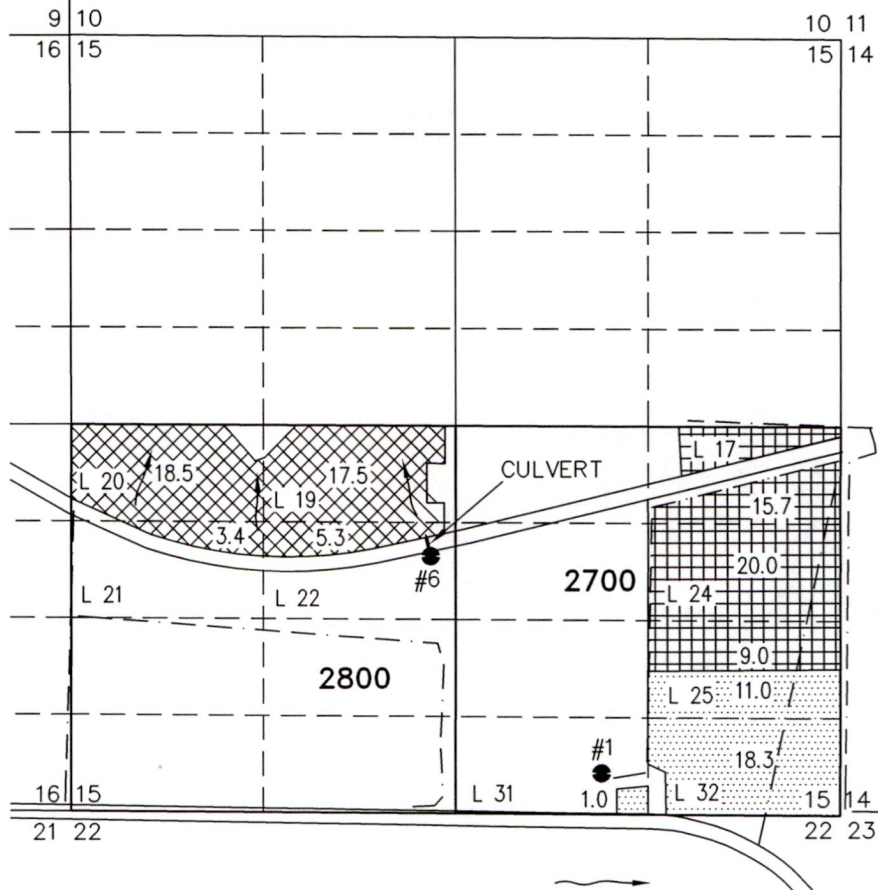

● WELL #1 (KLAM 1966) AUTHORIZED BY C41860, LOCATED 270 FEET NORTH AND 1620 FEET WEST FROM THE SE CORNER OF SECTION 15.

● WELL #6 (KLAM 1965) AUTHORIZED BY C20319 & PROPOSED FOR C41860, LOCATED 720 FEET SOUTH AND 200 FEET WEST FROM THE C 1/4 CORNER OF SECTION 15.

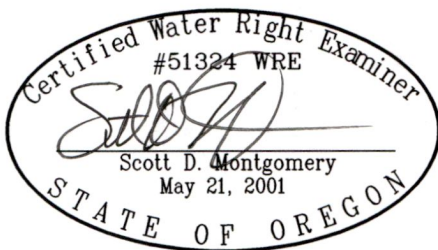

RENEWAL DATE: 12/31/2022

THIS MAP IS FOR THE PURPOSE OF LOCATING A WATER RIGHT ONLY AND HAS NO INTENT TO PROVIDE LEGAL DIMENSIONS OR THE LOCATION OF PROPERTY LINES.

SHEET FLOW

CONVEYANCE CANAL

 44.7 ACRES IR FROM WELL #6 TRANSFERRED ON FROM C 41860, AS SHOWN.

 44.7 ACRES IR FROM WELL #1 TRANSFERRED OFF FROM C 41860, AS SHOWN.

 30.3 ACRES IR FROM WELL #1 REMAIN, AS SHOWN FROM C 41860.

PROJECT No. 21-137

PREPARED AT THE REQUEST OF:

MARTIN RANCHES, LP
2021 STATE HWY 88
IONE, CA 95640

ALL POINTS ENGINEERING
& SURVEYING, INC.



P.O. BOX 767
TERREBONNE, OREGON 97760


(541) 548-5833 PH

Scott@APEandS.com

www.APEandS.com

11124

T.36S.R.11E.W.M.

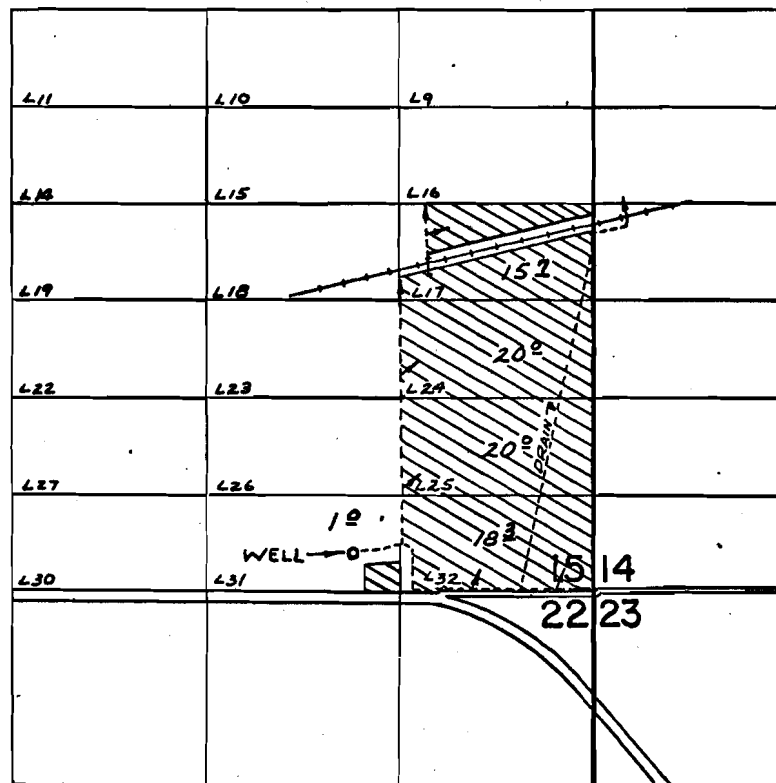

WELL LOC: 270' N. & 1620' W. FROM S.E. COR. SEC. 15

FINAL PROOF SURVEY UNDER

Application No. G-2722 Permit No. G-2588
IN NAME OF

Robert A. Johnson

Surveyed OCT. 22, 1974, by R. MUCKEN