


NOV 18 2020

ACMPC Oregon 2, LLC
Halls Ferry Farm
Transfer Application - Cert. 49817

OWRD

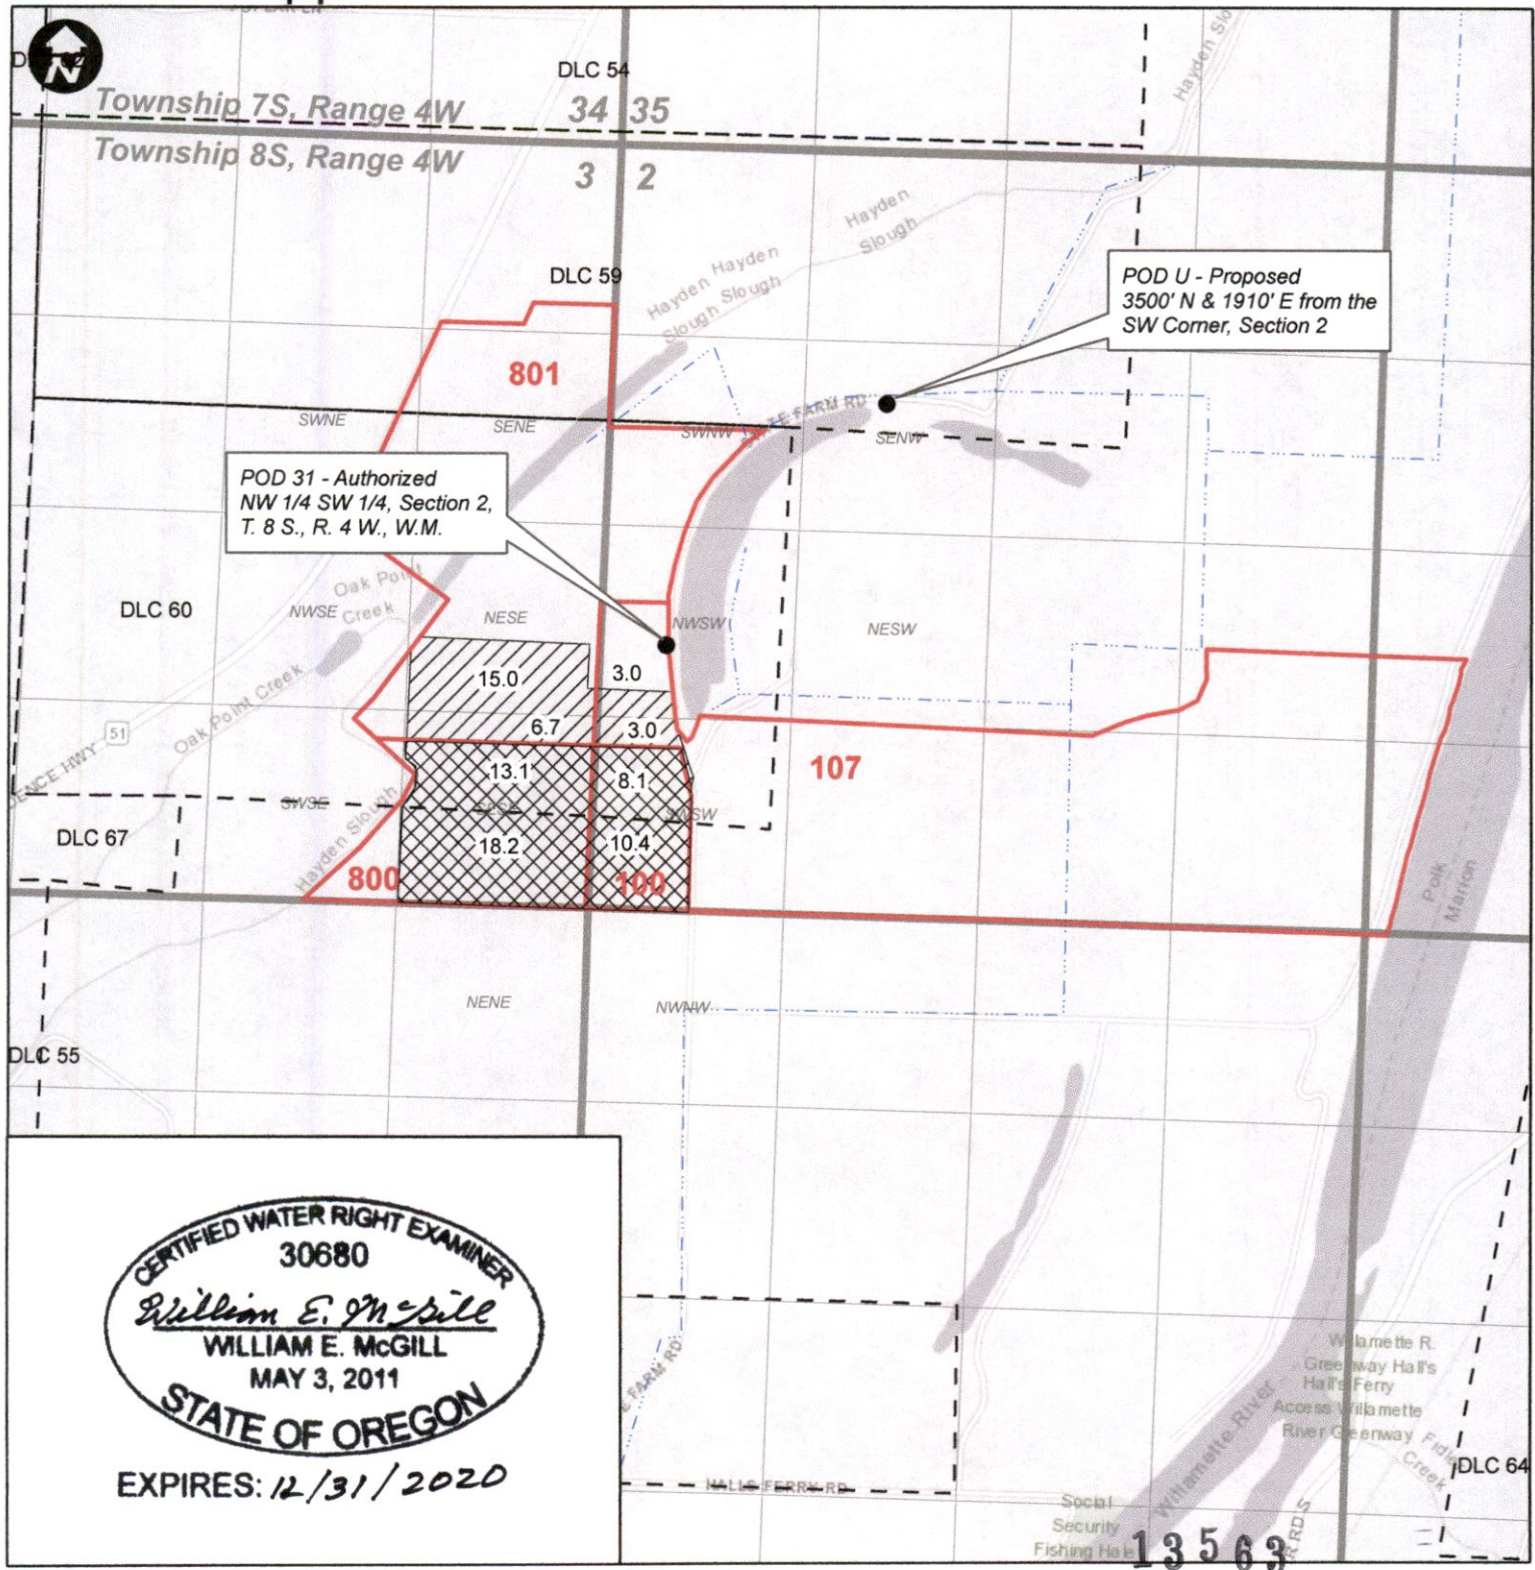

0 660 1,320 2,640 Feet

Legend

-  Cert. 49817 APOD Change  Irrigation Mainline  DLC
 Cert. 49817 No Change  Tax Lot



36

3

10

Scale 1 IN. = 20 Chs.