


ACMPC Oregon 2, LLC Halls Ferry Farm Transfer Application - Cert. 37342

RECEIVED

NOV 18 2020

OWRD

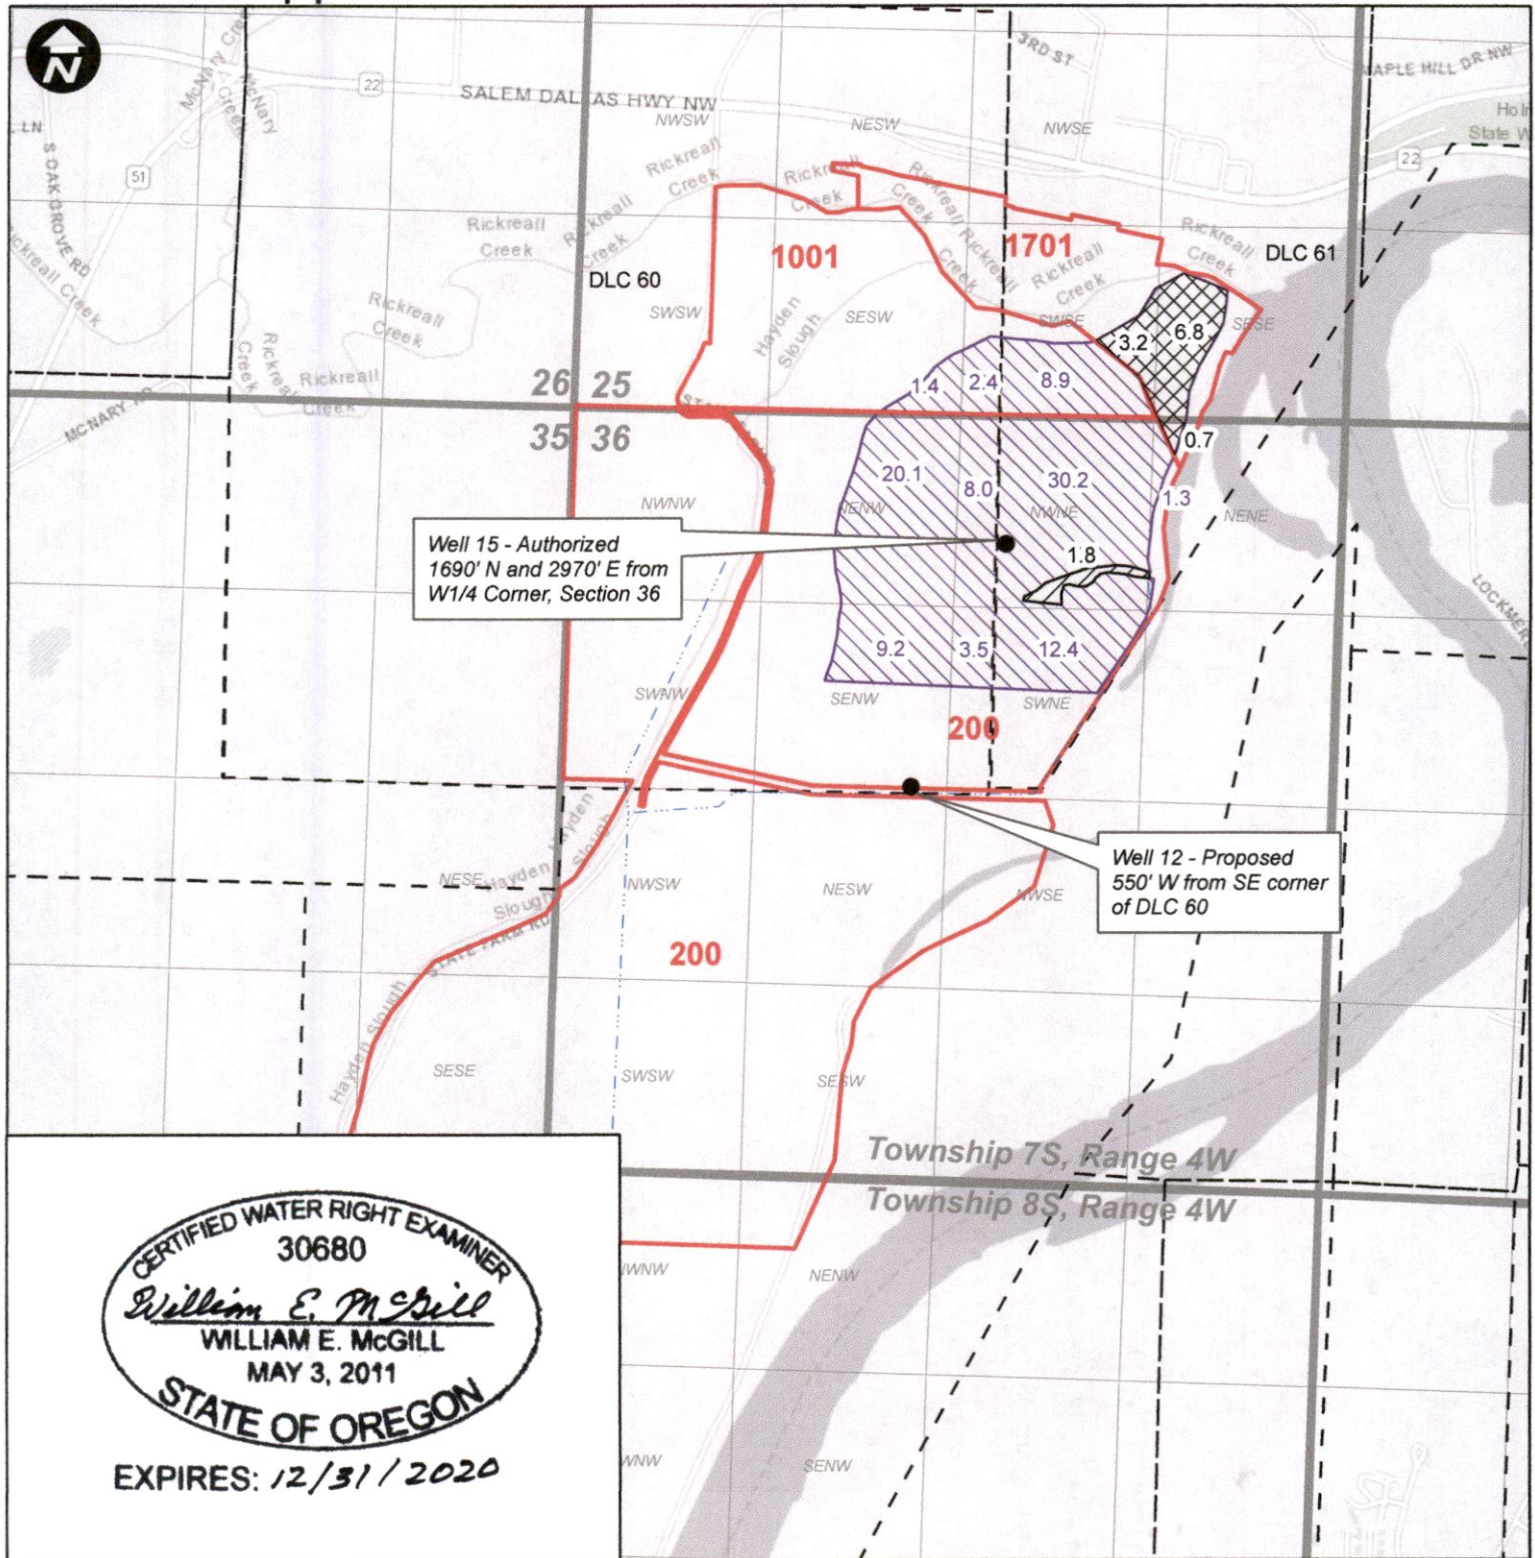

EXPIRES: 12/31/2020

0 660 1,320 2,640 Feet


Legend

- Cert. 37342 IR APOA Change
- Cert. 14257 No Change
- Tax Lot
- Cert. 37342 IS APOA Change
- Irrigation Mainline
- DLC

13563



T.7S.R.4W.W.M.

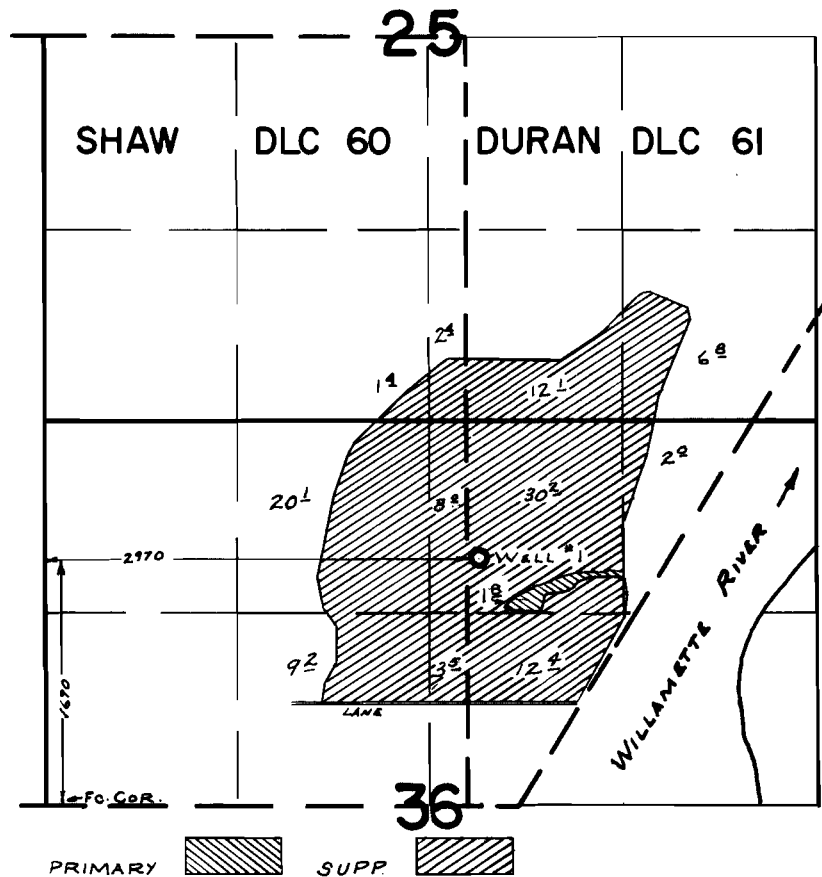

FINAL PROOF SURVEY
UNDER

Application No. G-2912 Permit No. G-2730
IN NAME OF

GREEN VILLA FARMS

Surveyed Aug. 11, 1969, by D. Buell