


P. 8186
8907

Twp 13 SR 28

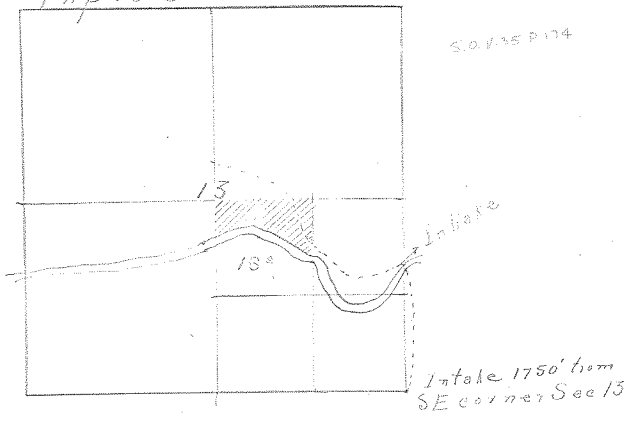

Application No	11777	11777
Tract No.	8186	8186