

FINAL PROOF SURVEY

UNDER

APPLICATION No. G-14139

PERMIT No. G-12871

IN NAMES OF

BENNIE L. MACHADO, CLAIR CARLTON AND ROBERT LEWIS

SURVEYED SEPT. 10, 1999

RECEIVED

SEP 30 1999


WATER RESOURCES DEPT.
SALEM, OREGON



1" = 400'

T39S
R7E R8E

W.M.

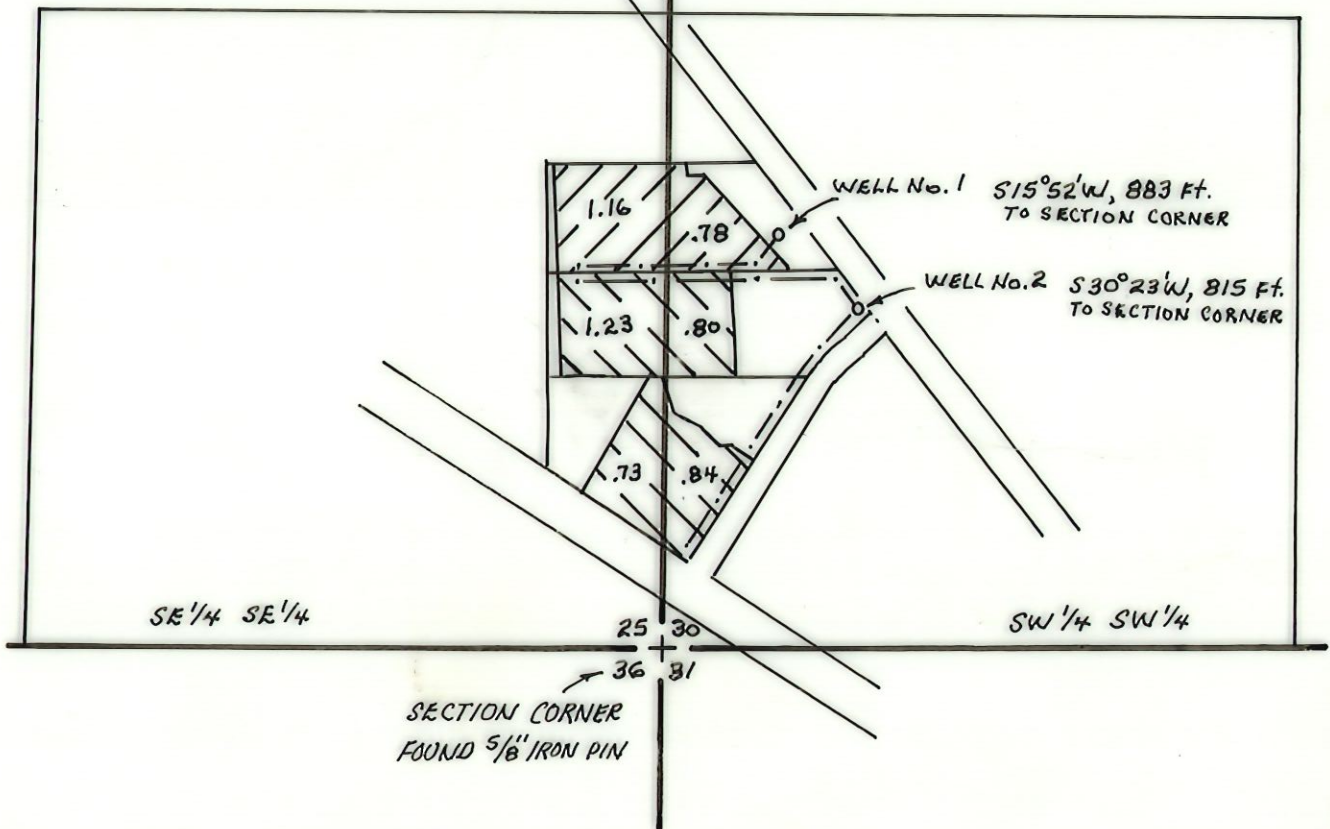

THIS MAP WAS PREPARED TO IDENTIFY THE
WATER RIGHT AND SHOULD NOT BE USED TO
DETERMINE PROPERTY BOUNDARIES.

