


Weyerhaeuser Co.; Aurora Forest Nursery

Application No. G-14159 Permit No. G-12935

Claim of Beneficial Use Submitted 11/17/1997 Revised 5/2/2019

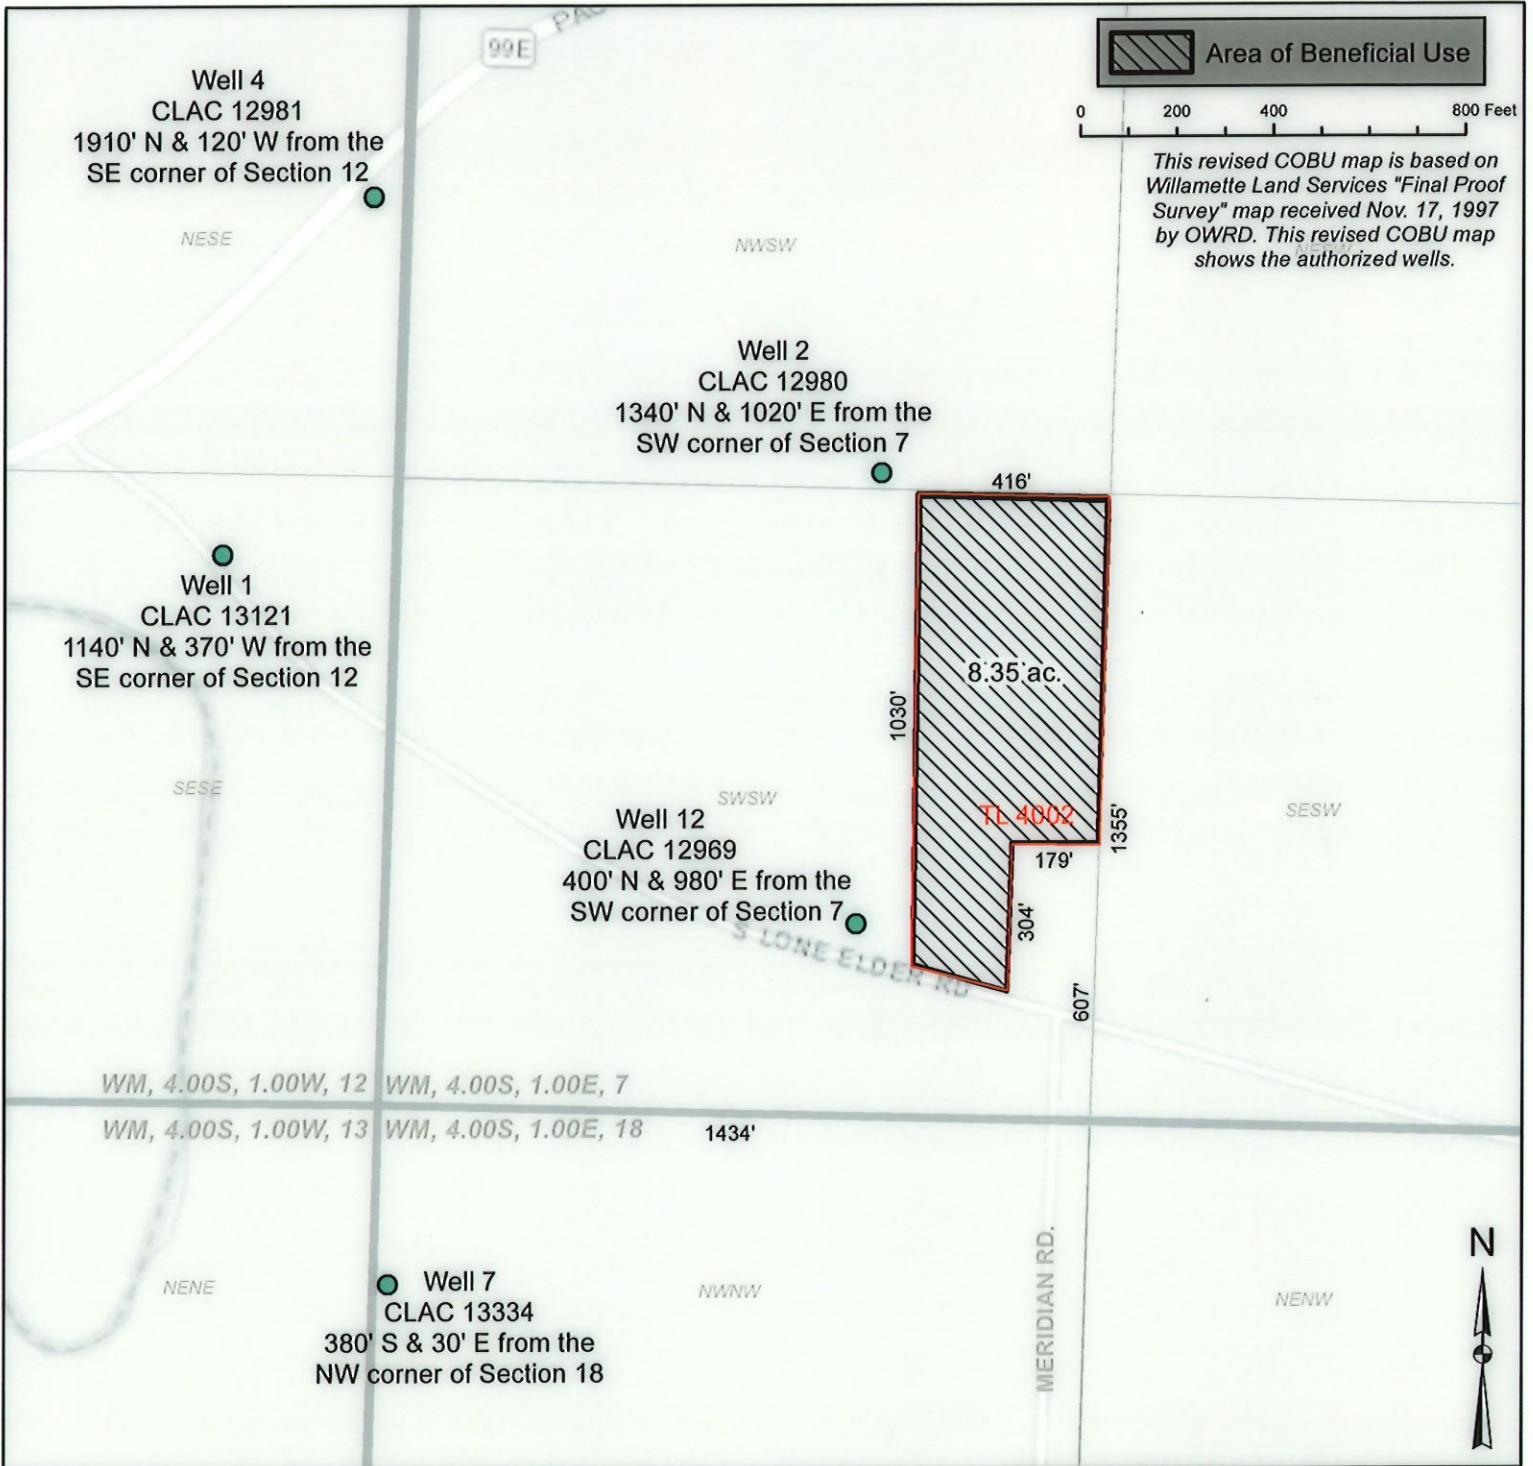

This map is not intended to provide legal dimensions or locations of property ownership lines.



EXPIRES: 12/31/2020

RECEIVED
MAY 11 2011
OWRD

WILL MCGILL SURVEYING, LLC
| 15333 Pletzer Rd. SE, Turner, OR 97132
| 503-510-3026, willmcgill.surveying@gmail.com