





WATER RIGHTS CLAIM OF BENEFICIAL USE FOR
 EUGENE CHRISTIAN FELLOWSHIP
 LOCATED IN
 TWP 17 S, RGE 3 W, SEC. 9.
 TAX LOTS #17-03-09-00-01100, 01600, 02802 AND 02807.
 LANE COUNTY, OREGON, W.M.
 APPLICATION # G-14160, PERMIT # G-12814
 TRANSFER # T-10883
 OCTOBER 2010



-  ACRES WATERED PERMIT # G-12814, WELL #1
-  ACRES TRANSFERED T- 10883
-  ACRES WATERED PERMIT # G-12814, WELL # 2.

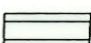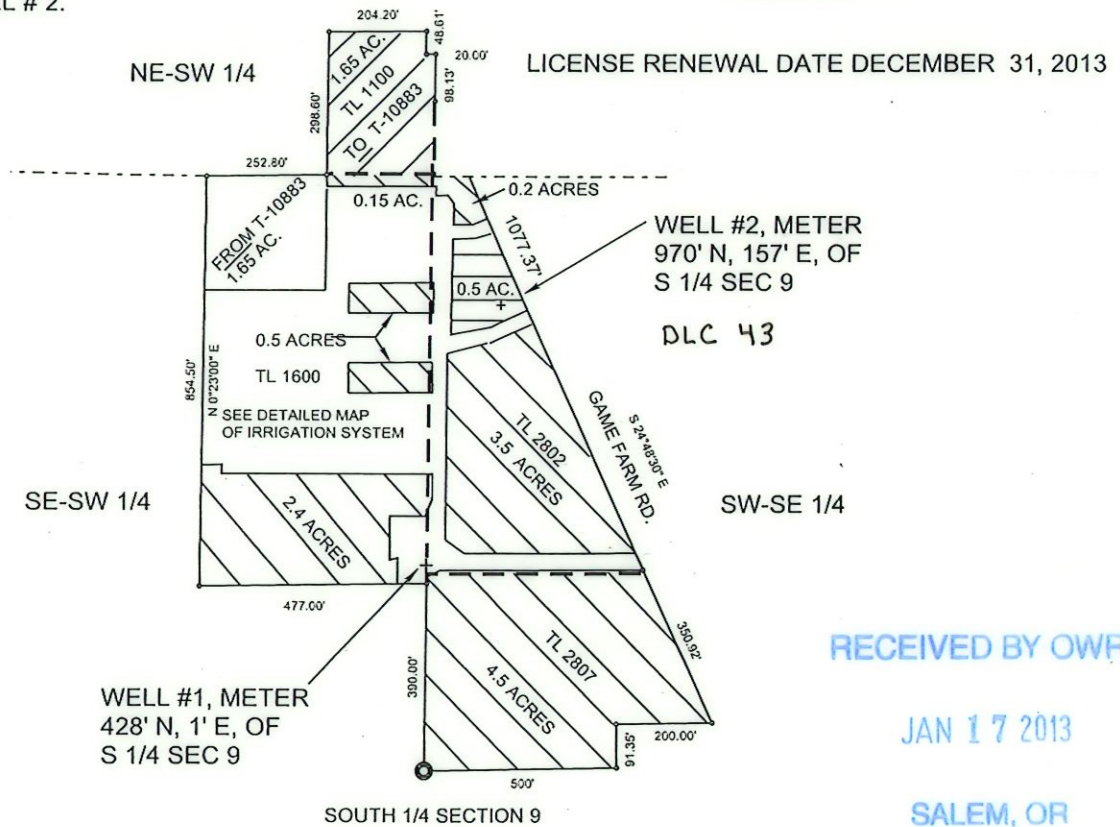

LEGEND	
+	POD: WELL # 1, WELL # 2
○	PROPERTY CORNER
---	TAX LOT LINE INTERIOR
●	BRASS DISK FOUND

DISCLAIMER: THIS MAP IS NOT TO BE USED FOR PROPERTY LOCATION. IT IS ONLY FOR WATER RIGHT PURPOSES ONLY.

NOTE: WATER LINES SHOWN ON SEPARATE MAP