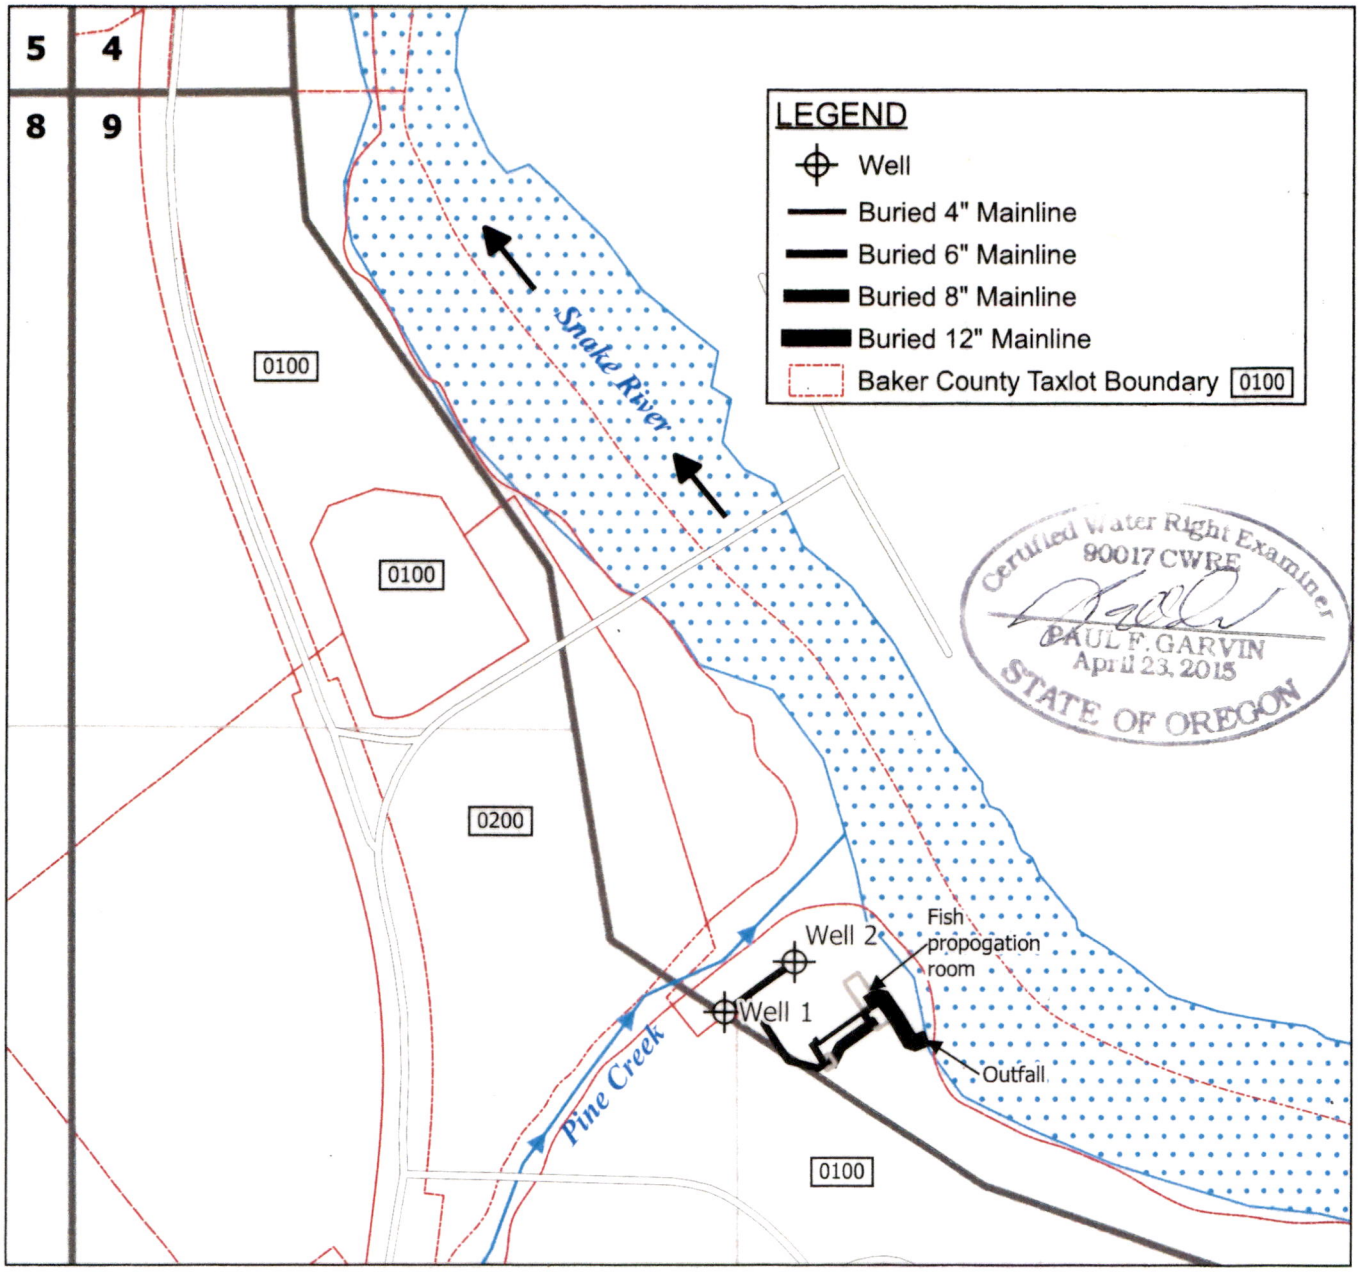

Received
OCT 15 2024
OWRD

Garvin HydroGeo LLC

Date: 9/23/2024
Drawn by: Paul F. Garvin

Application G-15318 Permit G-15440
Calim of Beneficial Use Map
Copperfield, OR

Prepared on behalf of Idaho Power

1 inch = 400 feet

IN

Note:

This map is not intended to provide legal dimensions or locations of property ownership lines.

Well 1 (BAKE 1862): 480 ft N and 1,350 ft E from the W 1/4 Corner of Section 9

Well 2 (BAKE 1861): 570 ft N and 1,540 ft E from the W 1/4 Corner of Section 9

Well 1 flowmeter located approximately 15 ft NE of Well 1

Well 2 flowmenter is located approximately 20 ft SW of Well 2