




CLAIM OF BENEFICIAL USE MAP

FOR PERMIT APPLICATION G-16421

SECTIONS 20, 22, 27, 28, AND 29,
TOWNSHIP 23 SOUTH, RANGE 27 EAST, W.M.
TAX LOT: 501


- #1 (HARN 50663)
LOCATED IN THE NE 1/4 NW 1/4 SECTION 27, T23S R27E, W.M. AND 1015' S AND 1700' E FROM NW CORNER SECTION 27. FLOW METER LOCATED 20' NORTH FROM WELL.
- #2 (HARN 51351/51463/52815)
LOCATED IN THE NW 1/4 NW 1/4 SECTION 28, T23S R27E, W.M. AND 1190' S AND 0' E FROM NW CORNER SECTION 28. FLOW METER LOCATED 8' EAST FROM WELL.

-  125.7 AC IR FROM #1 & #2
-  454.3 AC IS FROM #1 & #2

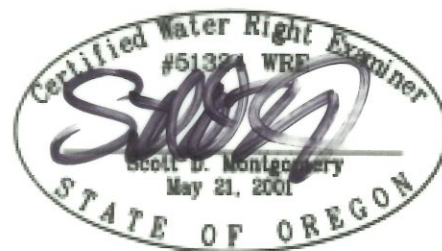

RENEWAL DATE: 12/31/2022

THIS MAP IS FOR THE PURPOSE OF LOCATING A WATER RIGHT ONLY AND HAS NO INTENT TO PROVIDE LEGAL DIMENSIONS OR THE LOCATION OF PROPERTY LINES

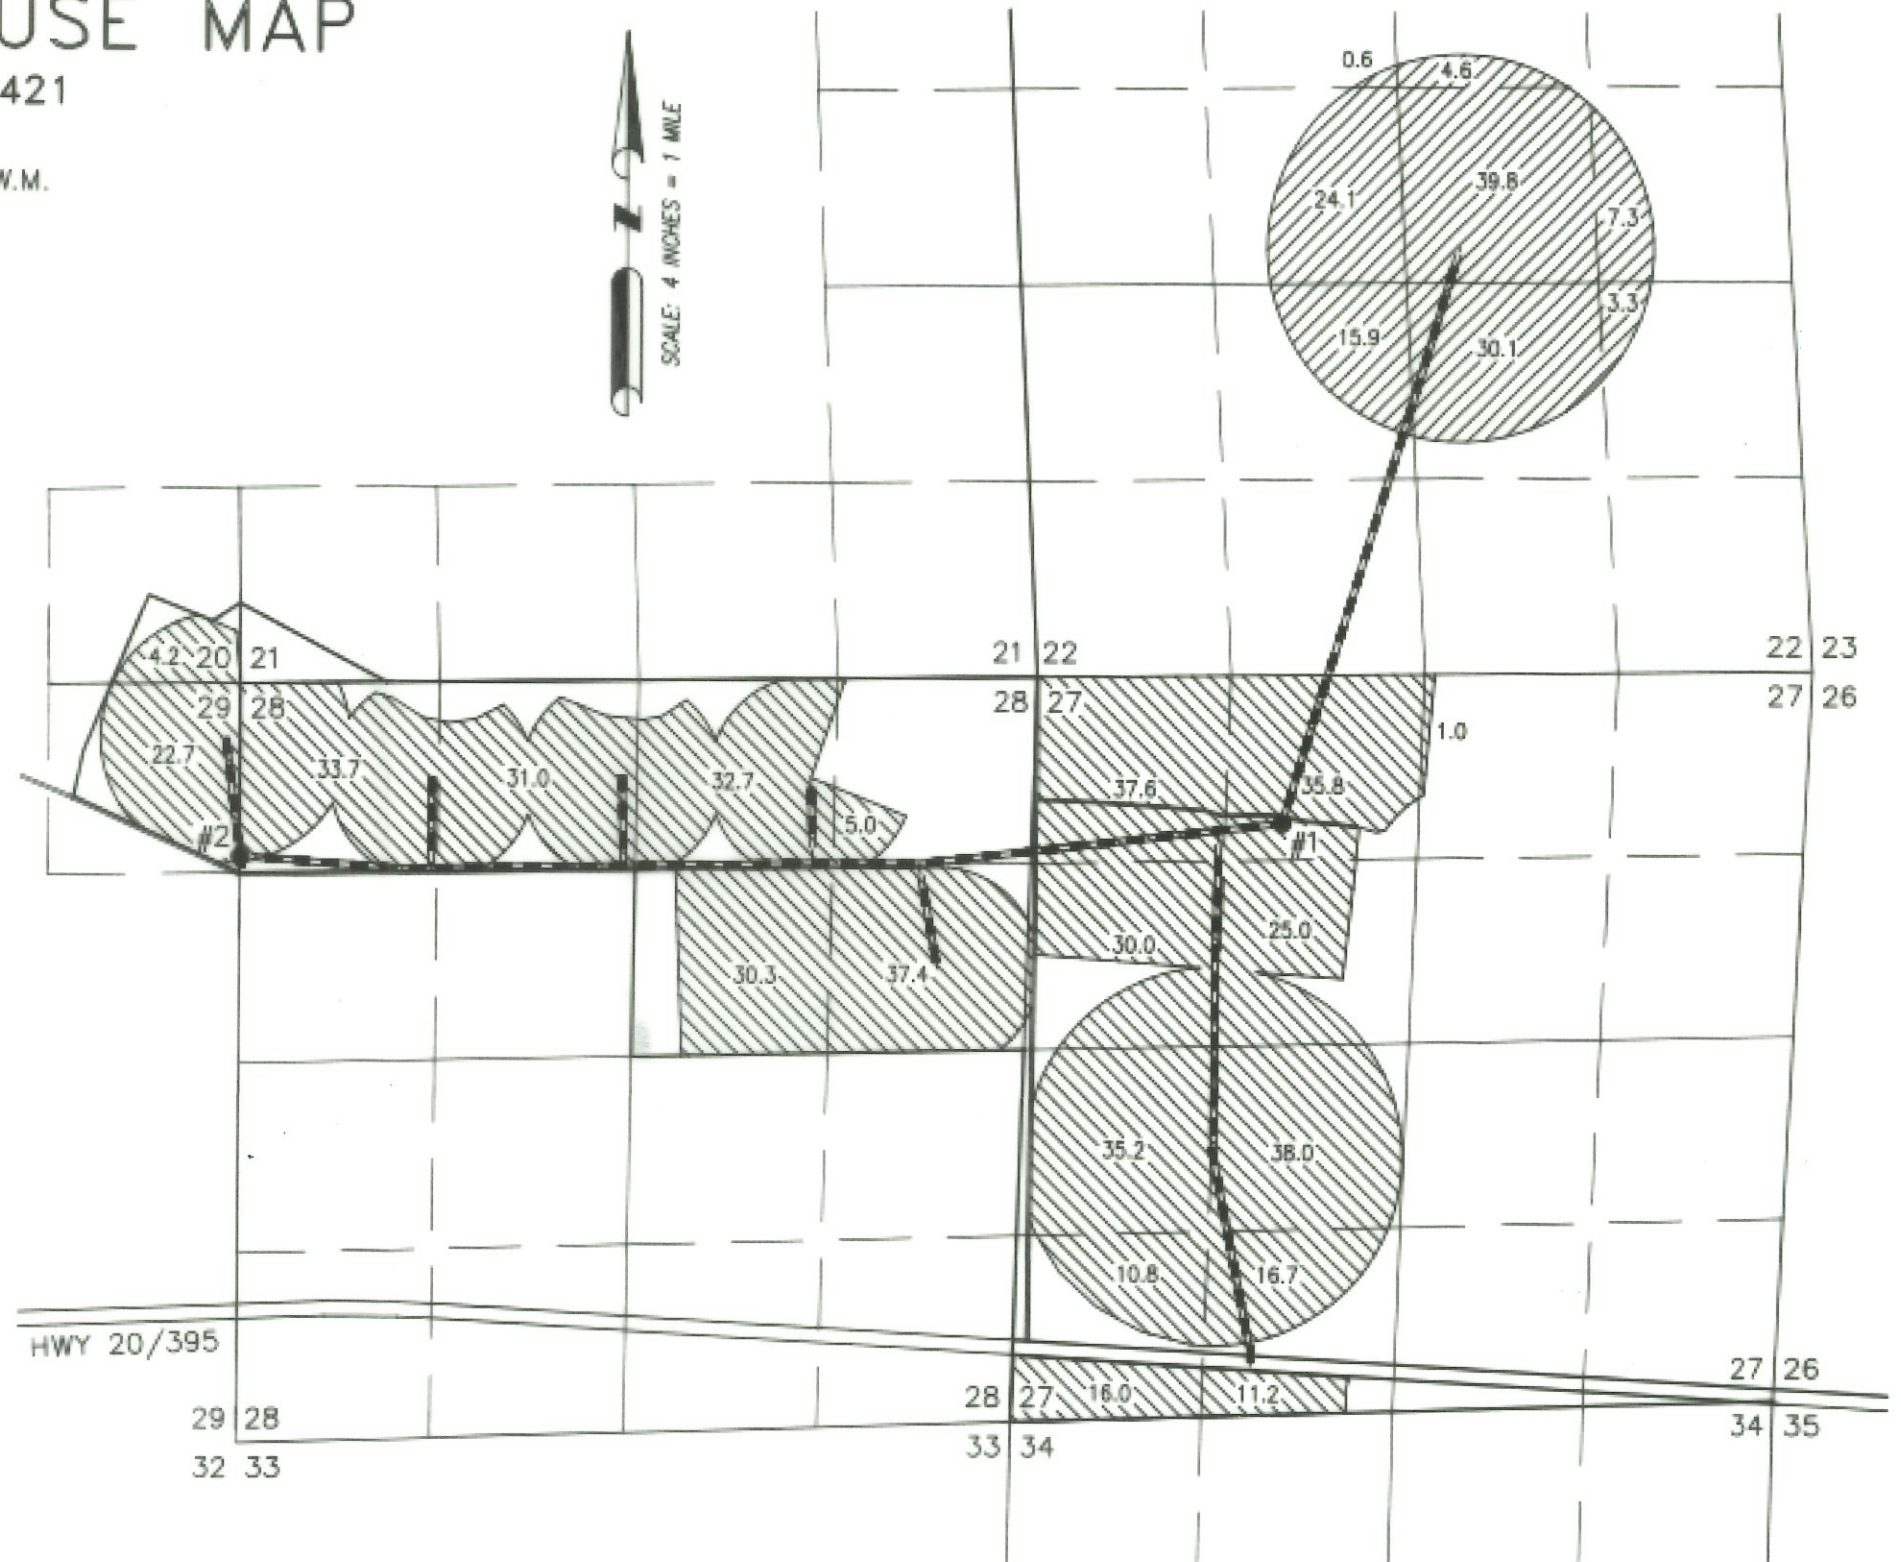

PREPARED FOR:

L, S, AND D LOGGING, INC.
P.O. BOX 970

PREPARED BY:



ALL POINTS ENGINEERING AND SURVEYING, INC.
P.O. BOX 767
TERREBONNE, OR 97760

120

COBU MAP # 1200