
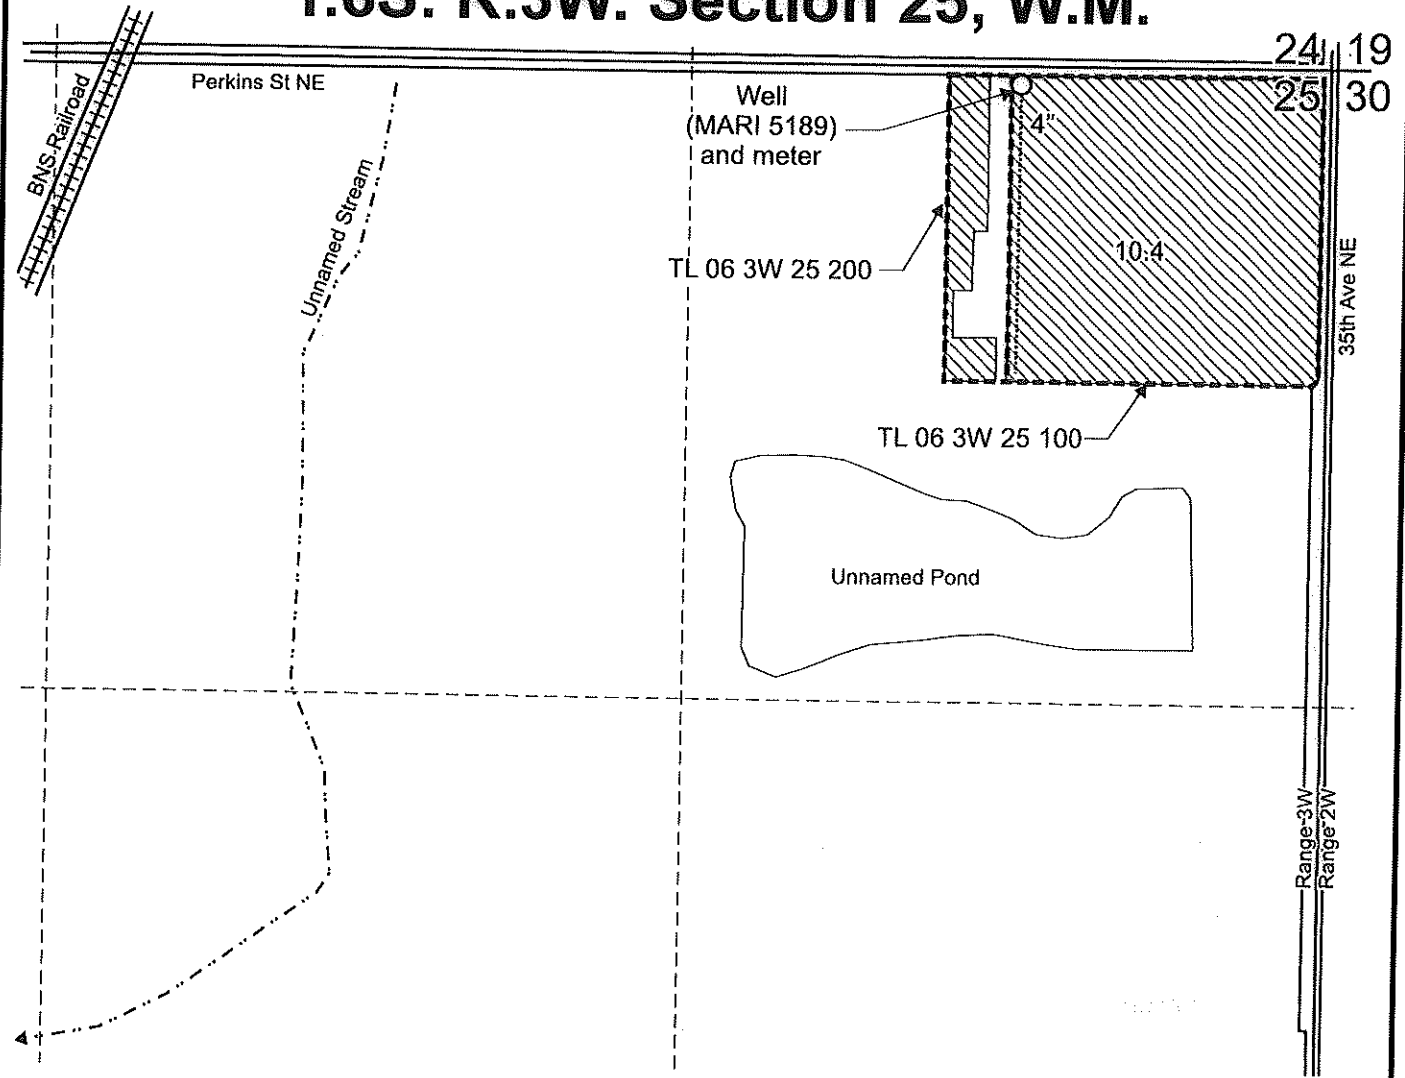


T.6S. R.3W. Section 25, W.M.

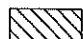


Well (MARI 5189) is located 35 feet south and 665 feet west from the NE corner, Section 25.

 Area (10.4 Acres) irrigated under Application G-16944, Permit G-16530.

----- Tax lot boundary

..... Water main line

Scale: 1" = 400'

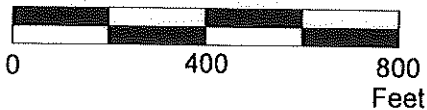

This map was prepared for the purpose of identifying the location of a water right only and is not intended to provide legal dimensions or location of property ownership lines.

Claim of Beneficial use Map
Application -16944, Permit G-16530

Alice Johnson
T.6S. R.3W. Section 25, W.M.

Pacific Hydro-Geology Inc.

02/2022