


Sec. 8

Tp. 36 S

R. 28 E

8536

9908

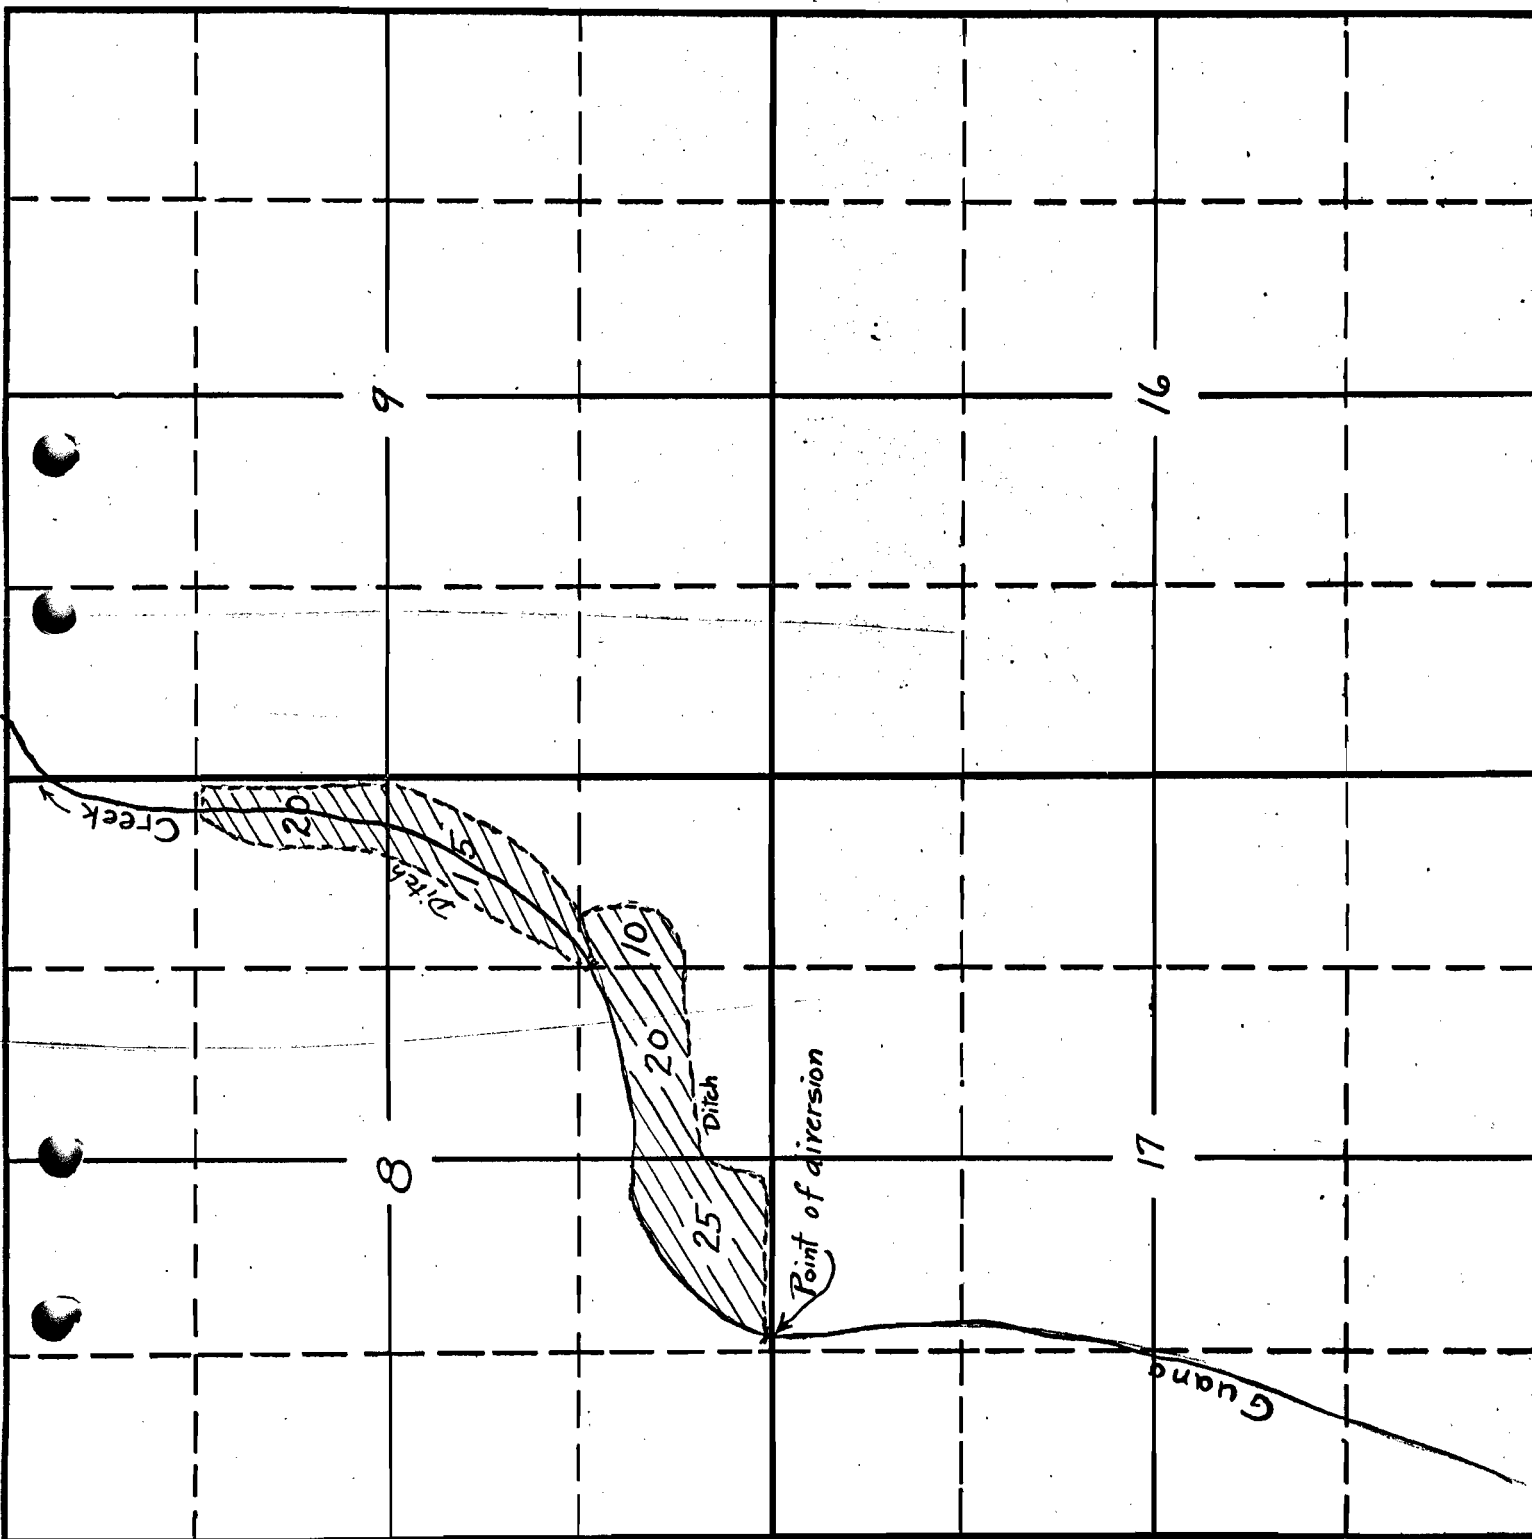

This map prepared by State Engineer from
Original submitted by Applicant which original
was on unsatisfactory paper.

Ap. No. 12087
Per. No. 8536