


CLAIM OF BENEFICIAL USE MAP

TO ADD POINTS OF APPROPRIATION AND PLACE OF USE
FOR PERMIT APPLICATION G-17447

SECTION 33, TOWNSHIP 23 SOUTH, RANGE 32.5 EAST
TAX LOT 5400 &

SECTIONS 4, 5, 8, & 9, TOWNSHIP 24 SOUTH, RANGE 32.5 EAST, W.M.
TAX LOTS: 100, 200, 300, 400, 500, 600, 700, 800, 900, 1500, 1700 & 2100

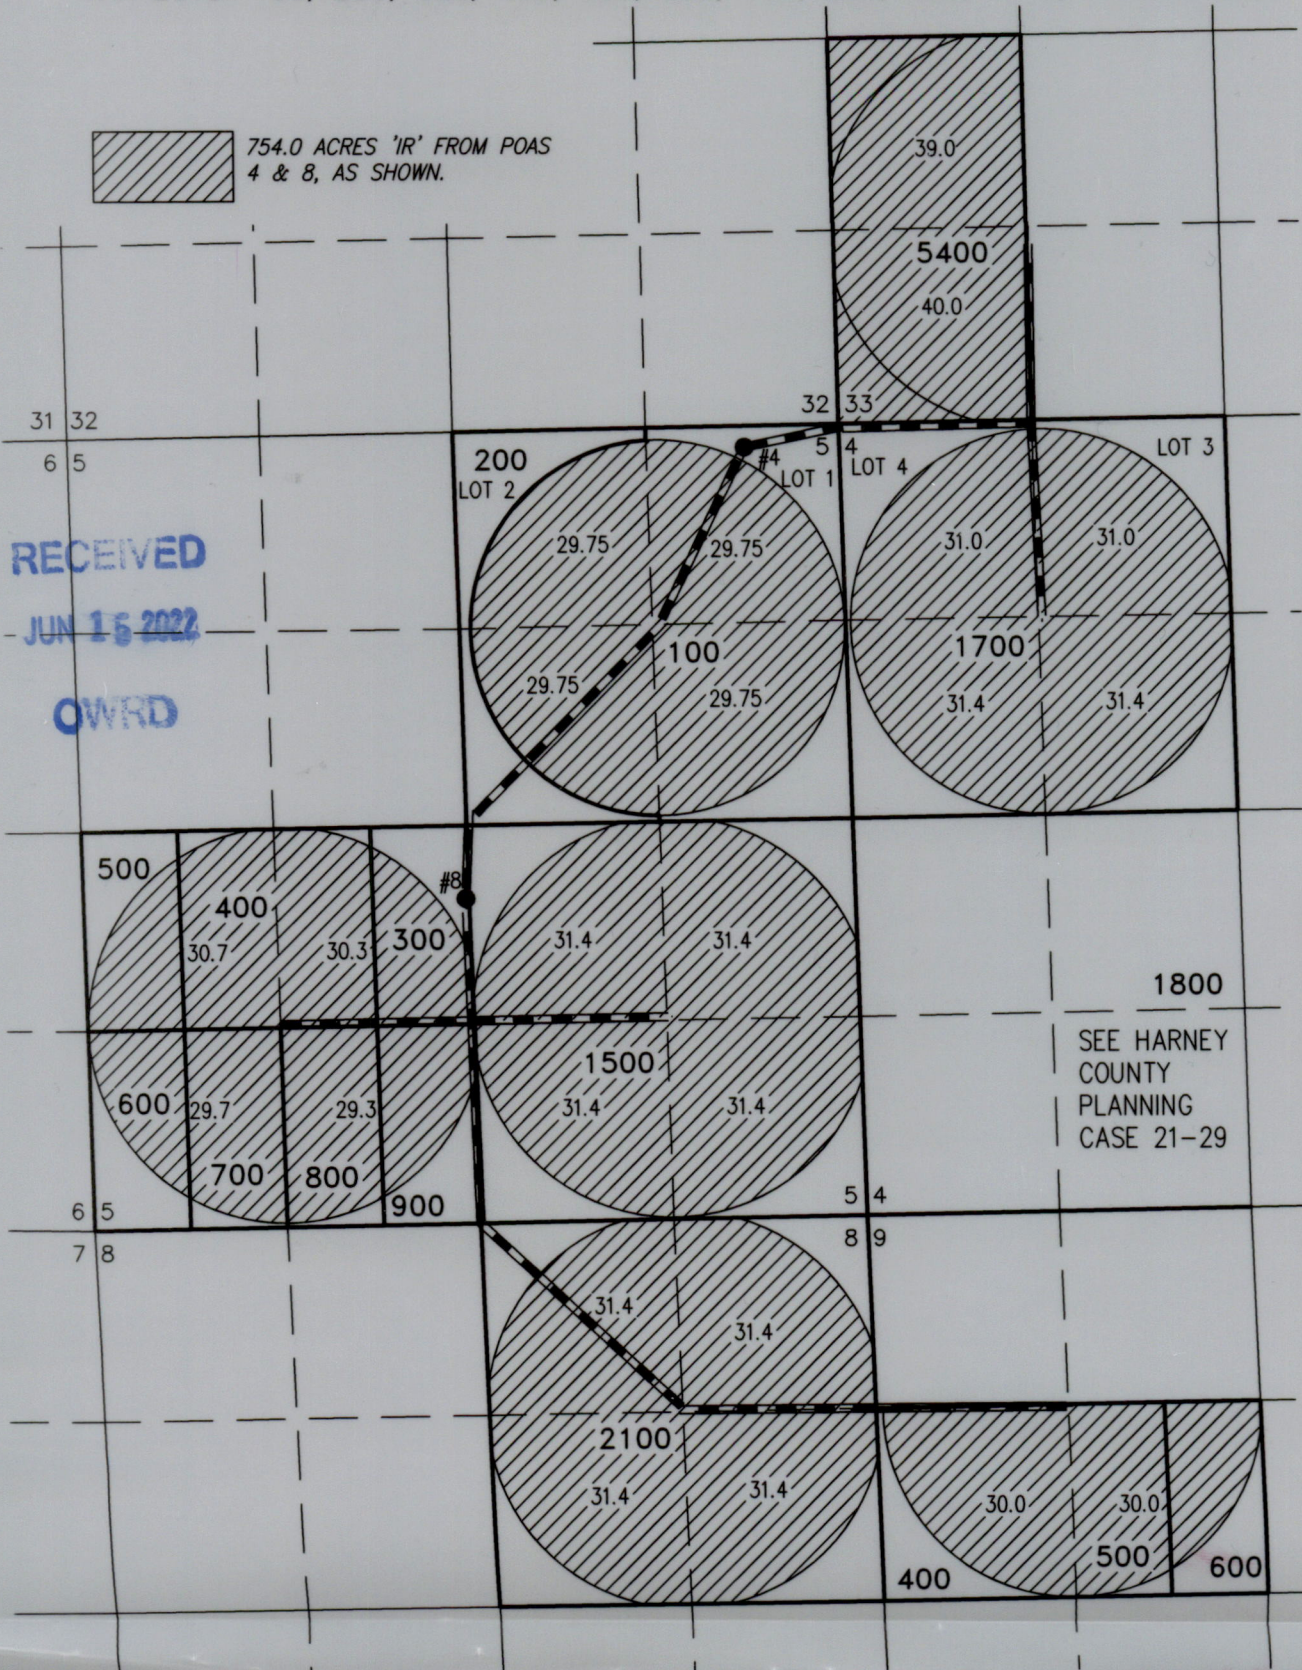

● #4
(HARN 52907) LOCATED 165' SOUTH & 660' WEST
FROM THE NE CORNER SECTION 5. FLOW METER IS
LOCATED 3 FEET NORTH FROM CENTER PIVOT.

● #8
(HARN 51825/51861) LOCATED 500'
SOUTH & 35' WEST FROM THE C 1/4
CORNER SECTION 5. FLOW METER IS
LOCATED 6 FEET NW FROM WELL.

THIS MAP IS FOR THE PURPOSE OF
LOCATING A WATER RIGHT ONLY AND HAS
NO INTENT TO PROVIDE LEGAL DIMENSIONS
OR THE LOCATION OF PROPERTY LINES



RENEWAL DATE: 12/31/2022

PREPARED FOR:

KEVIN THOMAS
37215 DEAD END LANE
BURNS, OR 97720

PREPARED BY:



ALL POINTS ENGINEERING AND SURVEYING, INC.
P.O. BOX 767 TERREBONNE, OR 97760
(541) 548-5833 www.APEandS.com