


Claim of Beneficial Use - Kraft

Application G-17889, Permit G-18269

Township 7S, Range 2W, W.M.

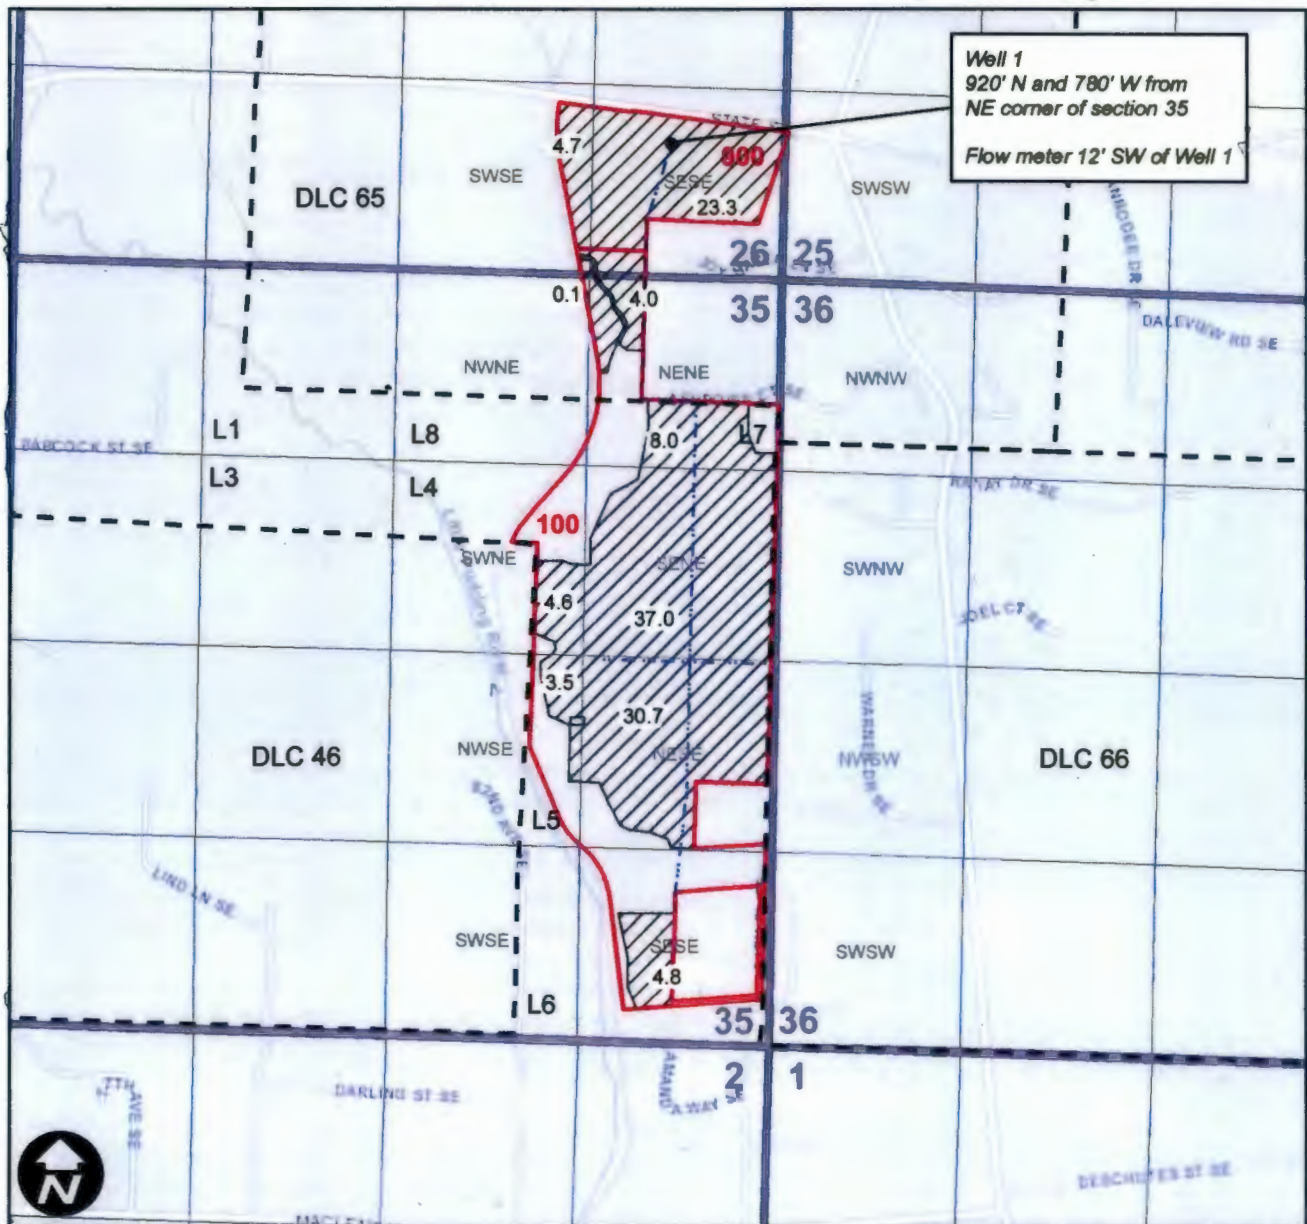

0 660 1,320 2,640 Feet

This map is not intended to provide legal dimensions or locations of property ownership lines.

Legend

- Place of Use
- Taxlots
- Mainline
- DLC



EXPIRES: 12-31-2024