COBU MAP #
1236

CLAIM OF BENEFICIAL USE MAP

TO ADD A POINT OF APPROPRIATION FOR T-11922 MOSBY FAMILY TRUST

SECTION 7, TOWNSHIP 31 SOUTH, RANGE 8 EAST, W.M.
TAX LOT: 1800

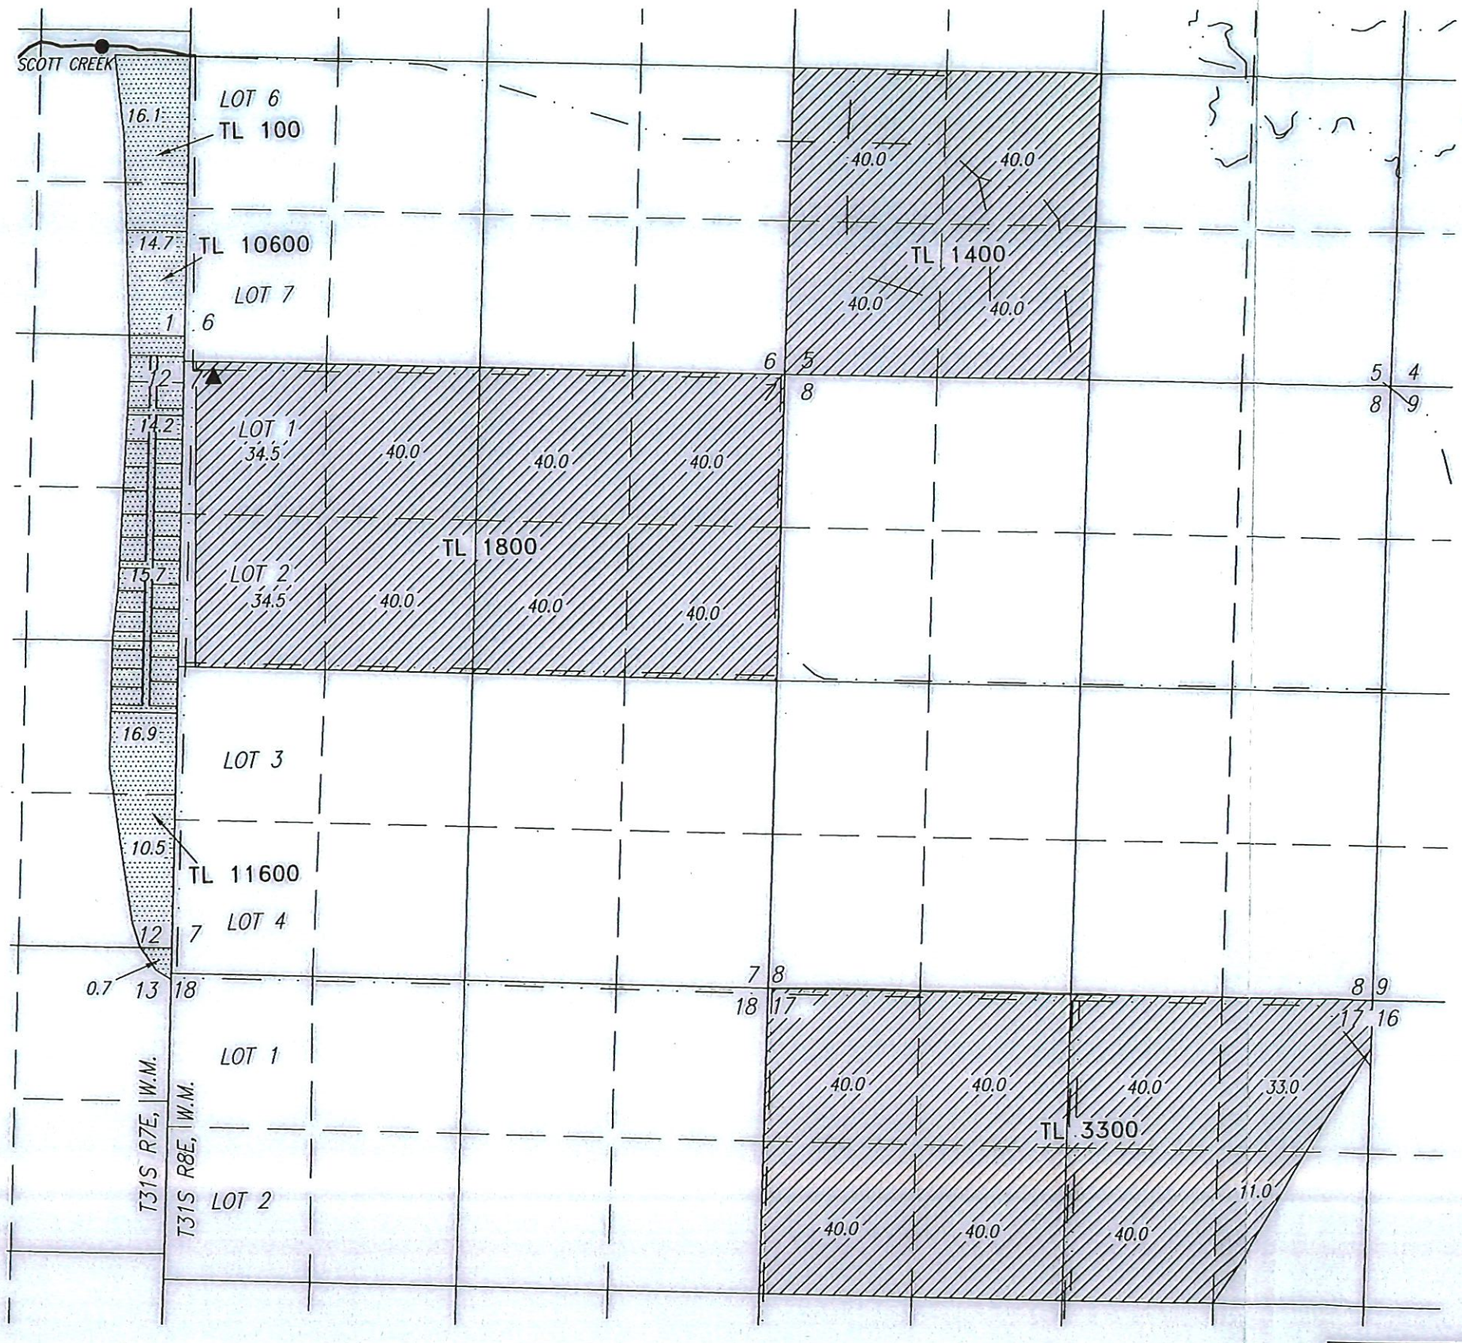

SCALE: 4 INCHES = 1 MILE

CANAL

- ● YAMSAY #2 – (KLAM 50590)
  NE 1/4 SE 1/4 SEC 1 T31S R7E
  70' N & 760' W FROM W 1/4 CORNER SEC 6 T31S R8E.
- ▲ BAR Y #1 – (KLAM 59411)
  NW 1/4 NW 1/4 SEC 7 T31S R8E
  140' S & 250' E FROM NW CORNER
  FLOWMETER LOCATED 11' EAST FROM WELL

753.0 ACRES SUPPLEMENTAL IRRIGATION FROM T-11922

88.8 ACRES SUPPLEMENTAL IRRIGATION FROM C-90001

RECEIVED
JUN 15 2020
OWRD

Certified Water Right Examiner
#51224 WRE
Scott D. Montgomery
May 21, 2001
STATE OF OREGON

RENEWAL DATE: 12/31/2020

THIS MAP IS FOR THE PURPOSE OF LOCATING A WATER RIGHT ONLY AND HAS NO INTENT TO PROVIDE LEGAL DIMENSIONS OR THE LOCATION OF PROPERTY LINES

PREPARED FOR:	PREPARED BY:
MOSBY FAMILY TRUST 294 BITTERROOT DRIVE LEWISTOWN, MT 59457	ALL POINTS ENGINEERING AND SURVEYING, INC. P.O. BOX 767 TERREBONNE, OR 97760 (541) 548-5833 www.APEandS.com