


Application G-18003, Permit G-17558 Claim of Beneficial Use Woodburn Organic Farms LLC

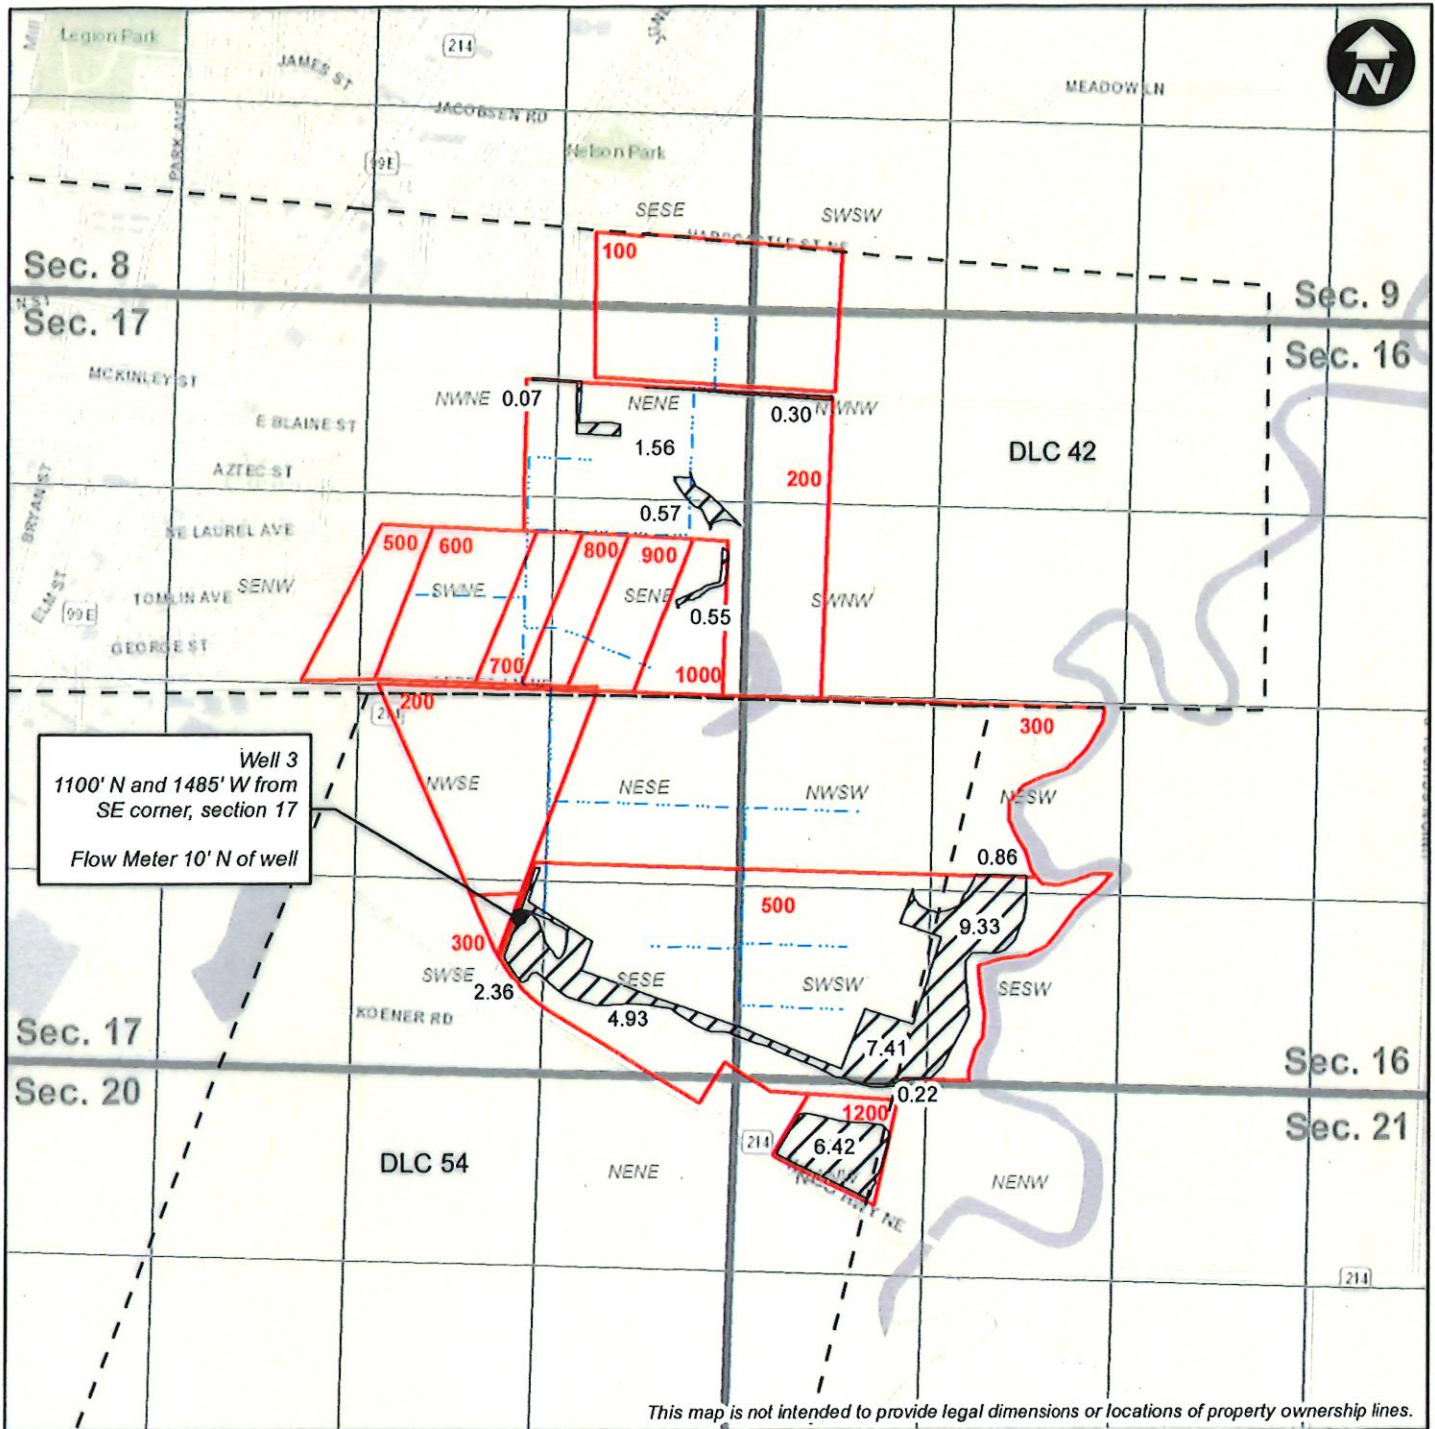

Legend

- Developed POU
- Taxlots
- Mainline
- DLC

CERTIFIED WATER RIGHT PLANNER
 30680
William E. McGill
 WILLIAM E. MCGILL
 MAY 3, 2011
 STATE OF OREGON

EXPIRES: 12/31/2022