


RECEIVED
 DEC 27 2022
 OWRD

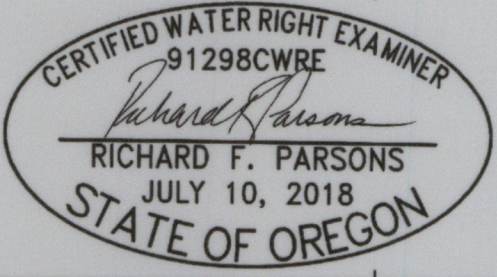


DARREN GLAHN
 14010 HWY 62
 EAGLE POINT, OR 97524

This map is not intended to provide legal dimensions or locations of property ownership lines

CLAIM OF BENEFICIAL USE

APPLICATION G-18361
 PERMIT G-18604

SECTION 22, TOWNSHIP 35 S
 RANGE 1 W, W.M.
 JACKSON COUNTY OREGON

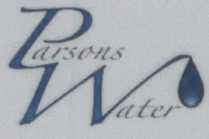

ParsonsWater Consulting LLC
 rick.parsons@parsonwater.com
 541.499.0257 303.667.5067

● G-18064 POA, METER, TANKS
 2125' NORTH and 2175' EAST
 OF SW 1/4 CORNER
 SECTION 22, T35S R1W

▨ POU
 7 ACS NE SW SECTION 22
 T35S, R1W

— IRRIGATION DRIP TAPE

