


T. 5S, R. 1W, W.M. Sections 15 & 16

SUPERSEDING

(Cert. 68344)
From Lands: 20.0-ac
POA/POU: 10.0-ac
POA: 10.0-ac

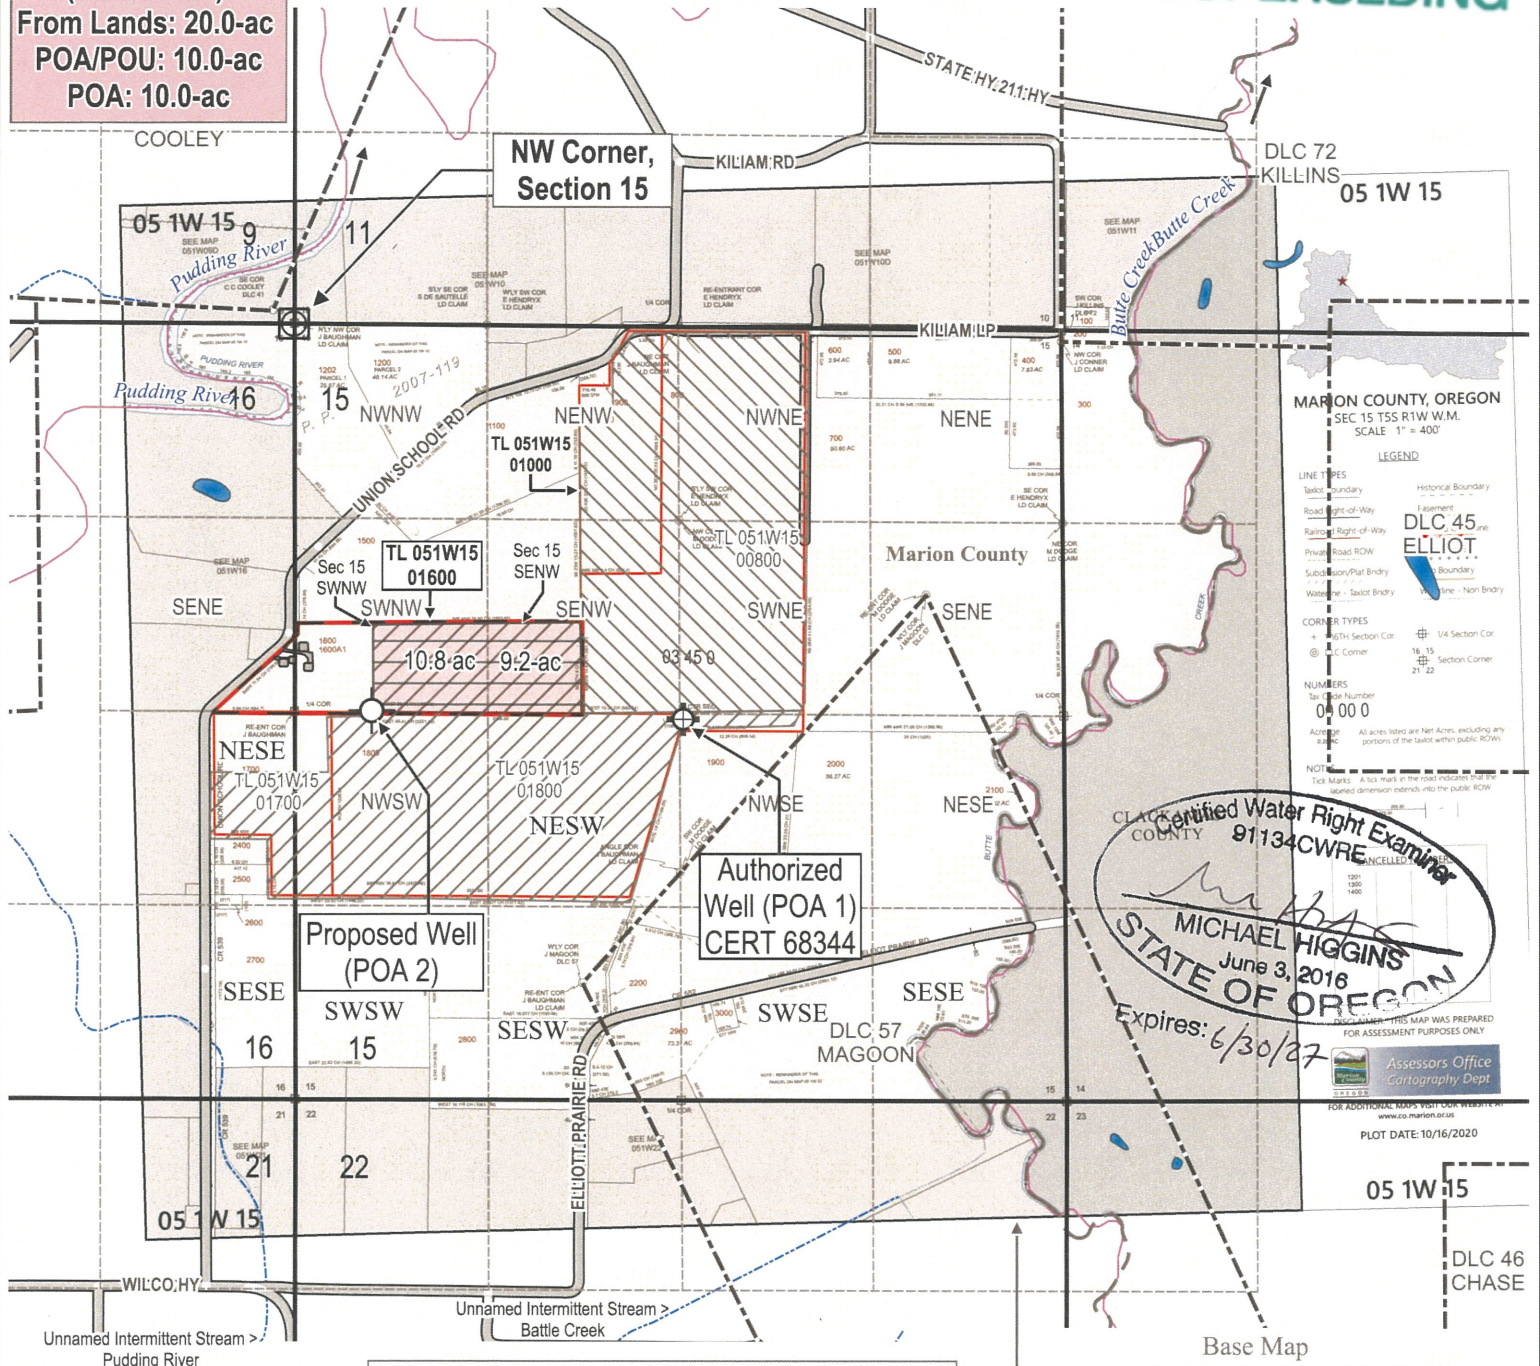

Certified Water Right Examiner
91134CWRE
Michael Higgins
STATE OF OREGON
Expires: 6/30/27


Authorized Well - POA 1 (MARI 1756): CERT 68344
Located South 2,720-ft, East 2,670-ft
from the NW corner of Section 15, T. 5S, R. 1W, W.M.

Transfer Proposed: (Cert. 68344)
From Lands (TL:1600; 20.0-ac)
POA 2: Proposed Well* Location
*New well for IR: TL 1600 To Lands'

Water Rights: Cert. 68344
Priority Date: 1/3/1975
POA 1: MARI-1756
POU - Primary IR
> Remaining WR
POU - Supplemental IR
> Remaining WR

Marion County GIS
TL 051W15 01600 (Transfer)
CERT 68344 Tax Lots
County Line
Survey Corner
T. R. - Section
Quarter-Quarter (QQ) Line
Donation Land Claims
roads

Proposed New Well*:
POA 2 (TL: 1600; To Lands):
Located South 2,670-ft, East 525-ft
from the NW corner of Section 15,
T. 5S, R. 1W, W.M.

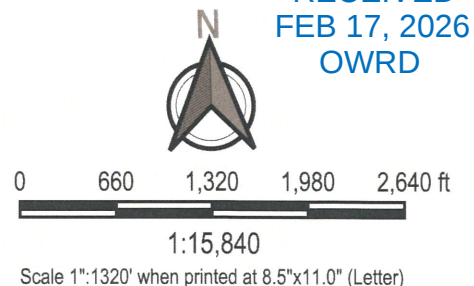


Source:
Project CRS: EPSG: 6557 - NAD83(2011) / Oregon GIC Lambert (ft)
GIS Data: OR Geospatial, OWRD, Marion County, DOGAMI, USGS

HGX Solutions, LLC
Date: January 21, 2026
Map Amendment

Map #1. From Lands: To Accompany Application for Permanent Transfer,
Under Certificate 68344
In the Name of Vitiritti Family Farm LLC
Tax Lot 1600, Tax Map 05 01W 15, Marion County, Oregon

T. 5S, R. 1W, W.M. Sections 15 & 16

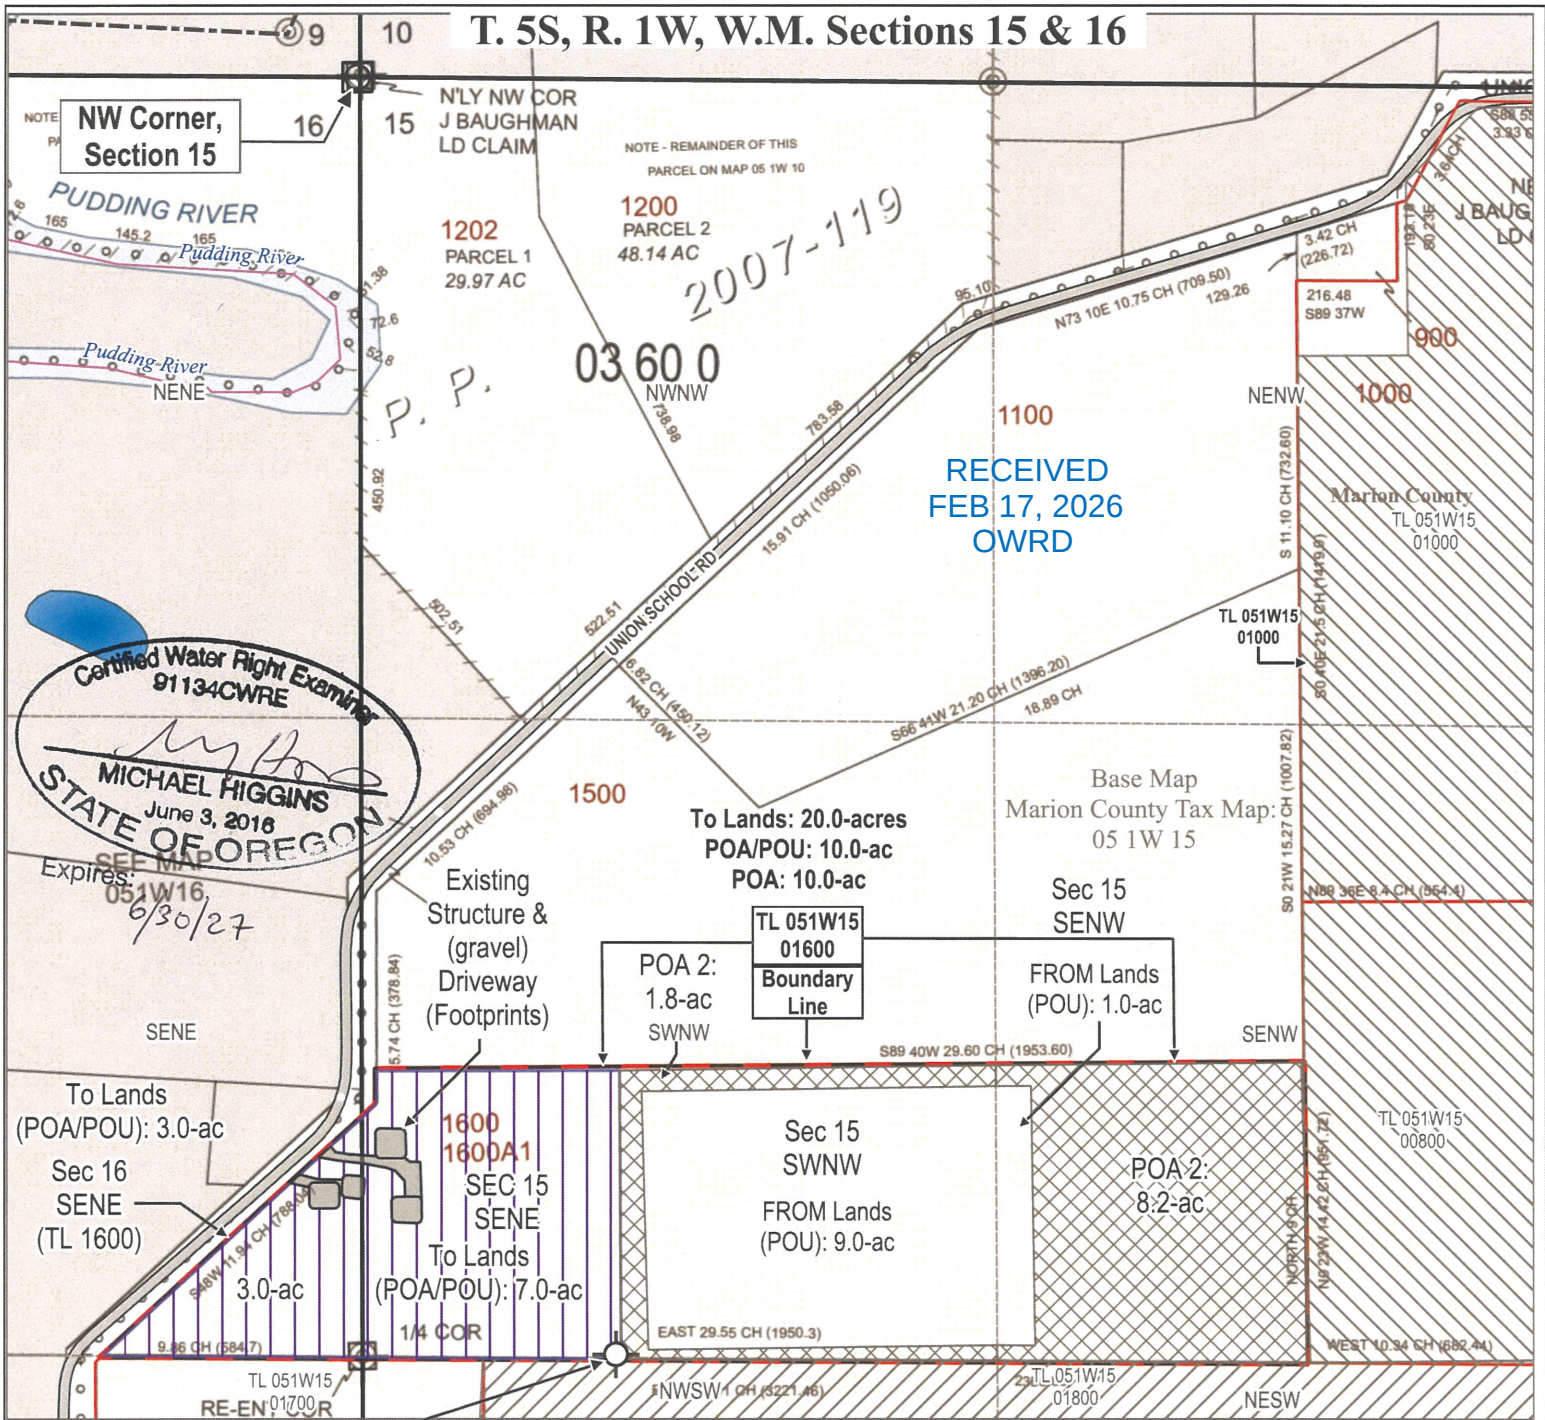

**Proposed Well
(POA 2)***

(TL 051W15 01600) Proposed Well* - POA 2:
*New for the Proposed To Lands: Located South 2,670-ft, East 525-ft
from the NW corner of Section 15, T. 5S, R. 1W, W.M.

Transfer Proposed: (Cert. 68344) Water Rights: Cert. 68344

- TL 051W15 01600
- POA/POU: To Lands (10.0-ac)
- POA: To Lands (10.0-ac)
- POA 2: Proposed Well* Location
- *New well for IR, 'To Lands'
- Structure & Driveway
(Mapped Footprint)

- Priority Date: 1/3/1975
- POU - Primary IR
- > Remaining WR
- POU - Supplemental IR
- > Remaining WR

Marion County GIS

- TL 051W15 01600 (Transfer)
- CERT 68344 Tax Lots
- County Line
- Donation Land Claims
- Survey Corner
- T. R. - Section
- Quarter-Quarter (QQ) Line
- roads



0 200 400 600 800 ft

1:4,800

Scale 1"=400' when printed at 8.5"x11.0" (Letter)

Source:
Project CRS: EPSG: 6557 - NAD83(2011) / Oregon GIC Lambert (ft)
GIS Data: OR Geospatial, OWRD, Marion County, DOGAMI, USGS

SUPERSEDING

HGX Solutions, LLC

Date: January 21, 2026

Map Amendment

Map #2. To Lands: To Accompany Application for Permanent Transfer,
Under Certificate 68344

In the Name of Vitritti Family Farm LLC

Tax Lot 1600, Tax Map 05 01W 15, Marion County, Oregon