

CLAIM OF BENEFICIAL USE MAP

TIDE CREEK RANCH, LLC

TAX LOT 300


LOCATED IN THE SE 1/4 SW 1/4, SECTION 30 AND
TAX LOTS 203, 204 AND 100 IN NE 1/4 NW 1/4 OF SECTION
31 T.6N., R1W., W.M.

ALSO IN THE DAVID AND LOUISA PURDUN DONATION LAND CLAIM
COLUMBIA COUNTY, OREGON



SCALE
1"=800'

DITCH RESERVOIR
PERMIT NO. 13218

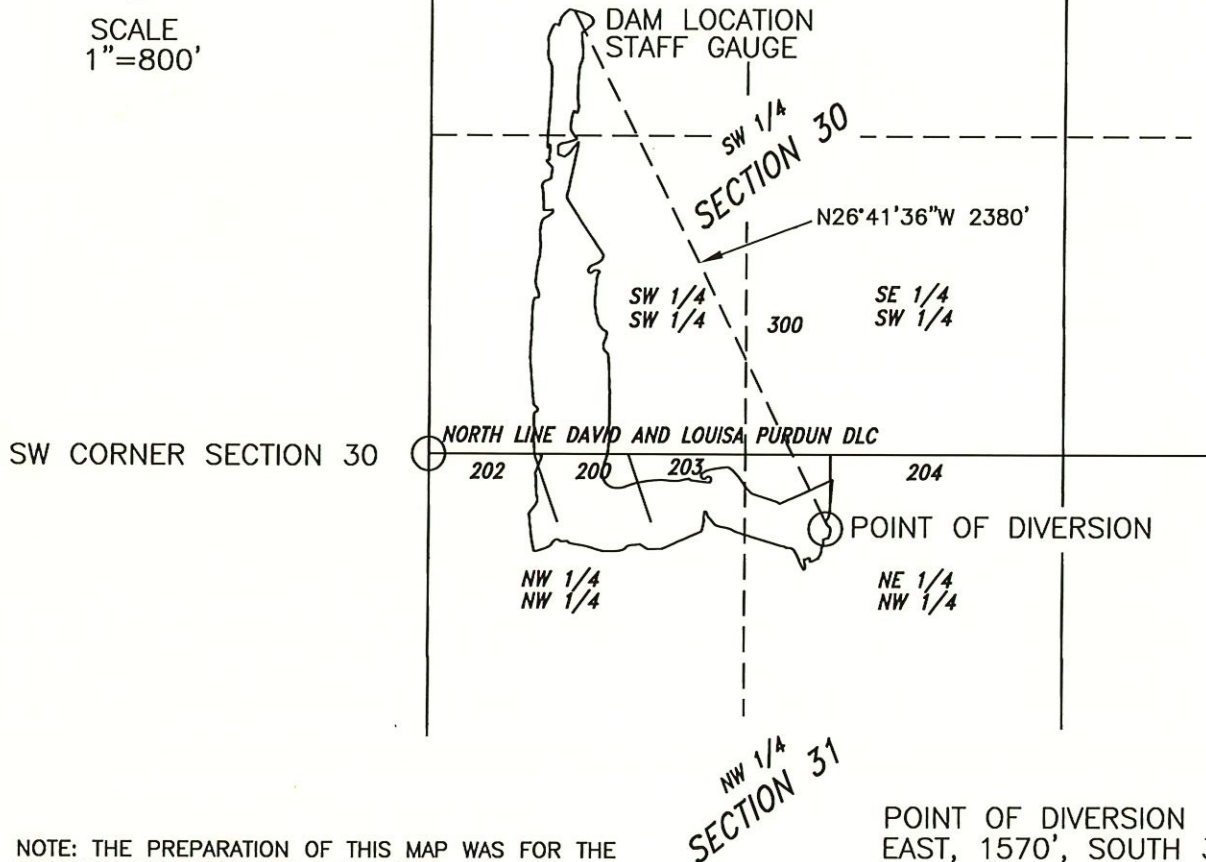


NOTE: THE PREPARATION OF THIS MAP WAS FOR THE
PURPOSE OF IDENTIFYING THE LOCATION OF THE
WATER RIGHT AND HAS NO INTENT TO PROVIDE
DIMENSIONS OR LOCATIONS OF PROPERTY
OWNERSHIP LINES.

POINT OF DIVERSION
EAST, 1570', SOUTH 307'
FROM SW CORNER OF SECTION 30
T.6N., R.1W., W.M

LOCATED IN
NE 1/4 NW 1/4 SECTION 31
SE 1/4 SW 1/4 SECTION 30
TOWNSHIP 5 NORTH, RANGE 1 WEST, W.M.

CLIENT:
TIDE CREEK RANCH
PO BOX 848
VANCOUVER, WASHINGTON

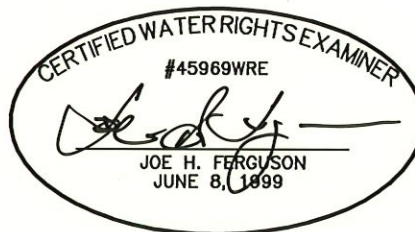

RECEIVED BY OWRD

AUG 08 2016

SALEM, OR

Ferguson Land Surveying, Inc.

646 SE 106TH AVE. PORTLAND, OR 97216
Phone (503) 408-0601 Fax (503) 408-0602

SHEET NO. 1 OF 1

JOB NO. 15-235 DITCH

DRAFTED 4/21/2016