


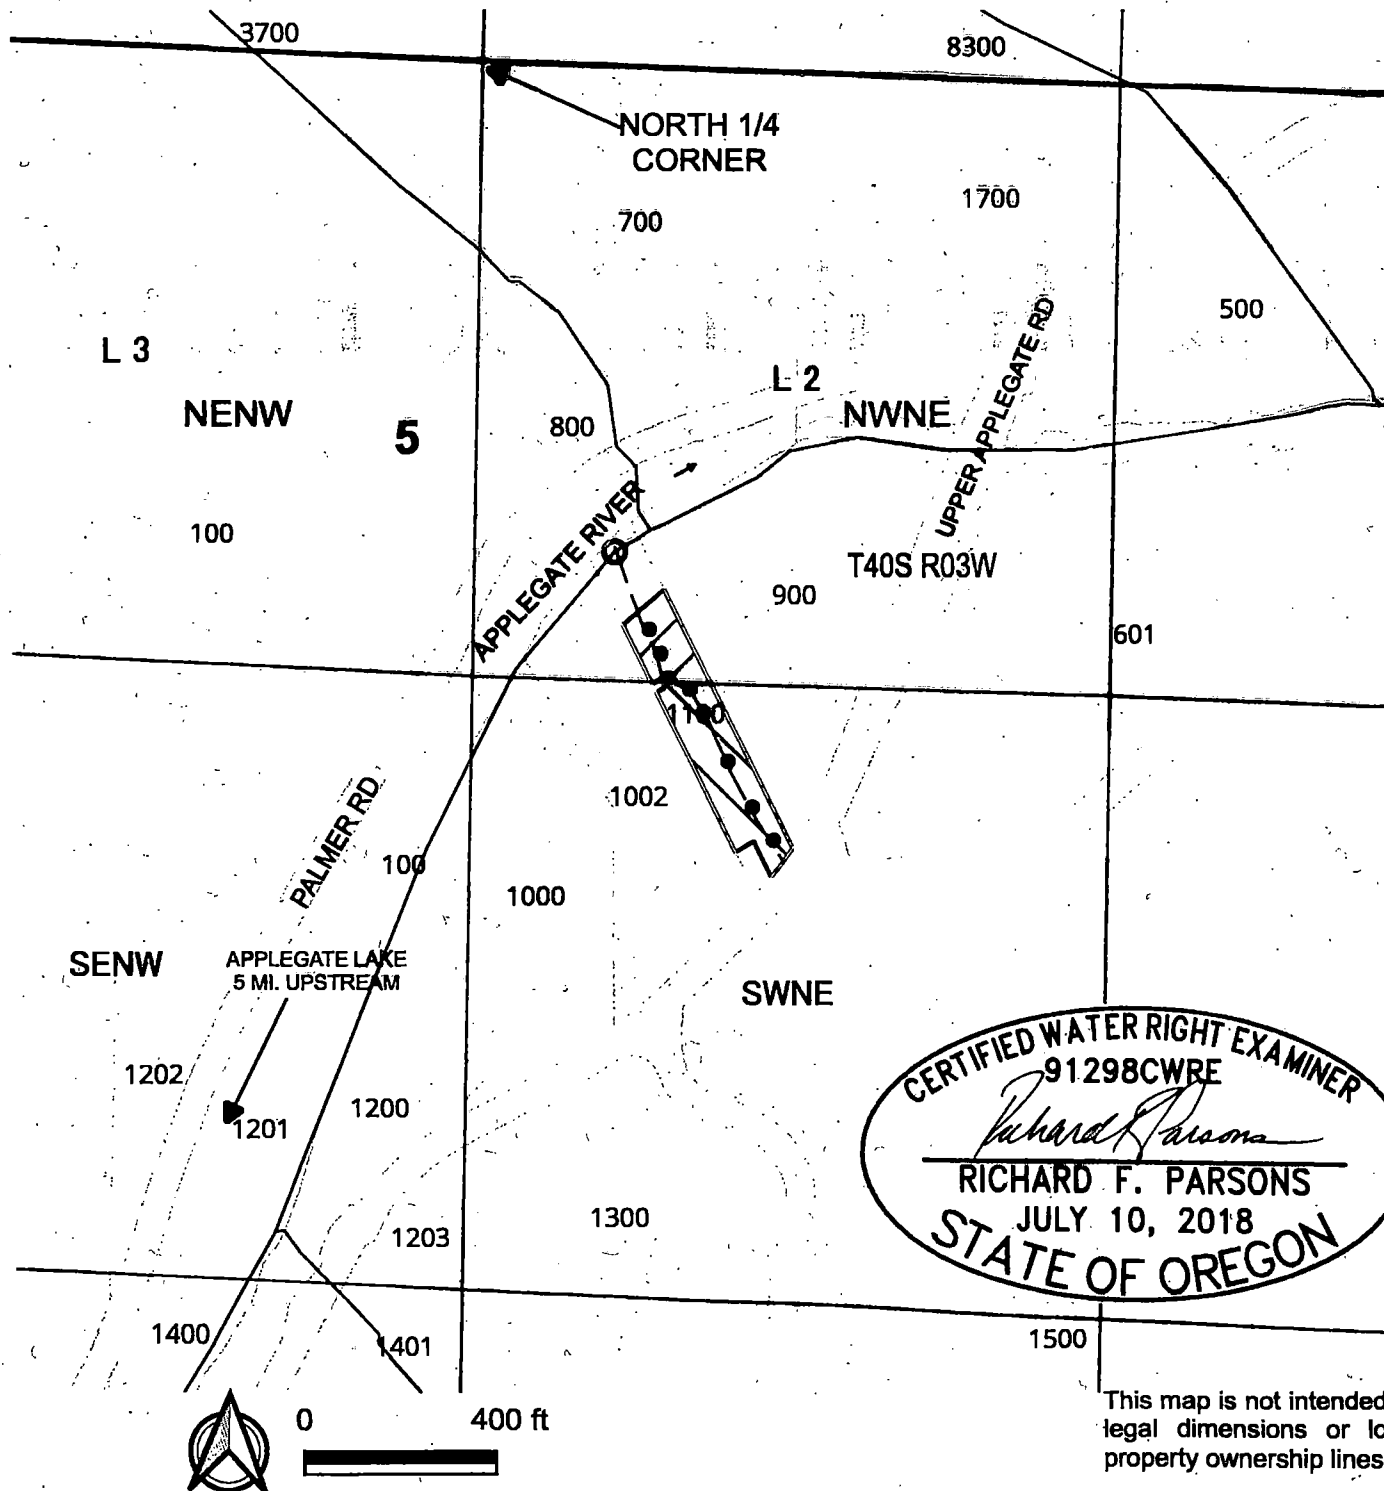

WARNER (RONALD) THAMES
9658 UPPER APPLGATE RD
JACKSONVILLE, OR 97530

CLAIM OF BENEFICIAL USE
APPLICATION NO. S-88839
PERMIT NO. S-55287

SITUATED IN
SECTION 5, TOWNSHIP 40S,
RANGE 3W, W.M.
JACKSON COUNTY, OREGON

LEGEND

○ POD, METER, FISH SCREEN
1025' SOUTH AND 295' EAST OF
NORTH QUARTER CORNER
SECTION 5

● SPRINKLERS

PLACE OF USE - 1.45 ACS




NW NE - 0.45 ACS (LOT 2)



SW NE - 1.0 ACS

— PIPELINES

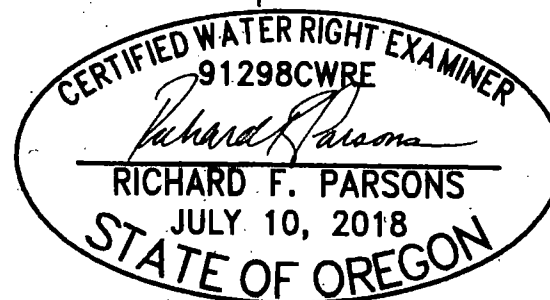

Received

JUL 10 2018

OWE

This map is not intended to provide
legal dimensions or locations of
property ownership lines

ParsonsWater Consulting LLC
rick.parsons@parsonwater.com
541.499.0257 303.667.5067